


# T.5S. R.2W. Sec. 34 & 35, W.M.

RECEIVED


OCT 18 2021

OWRD

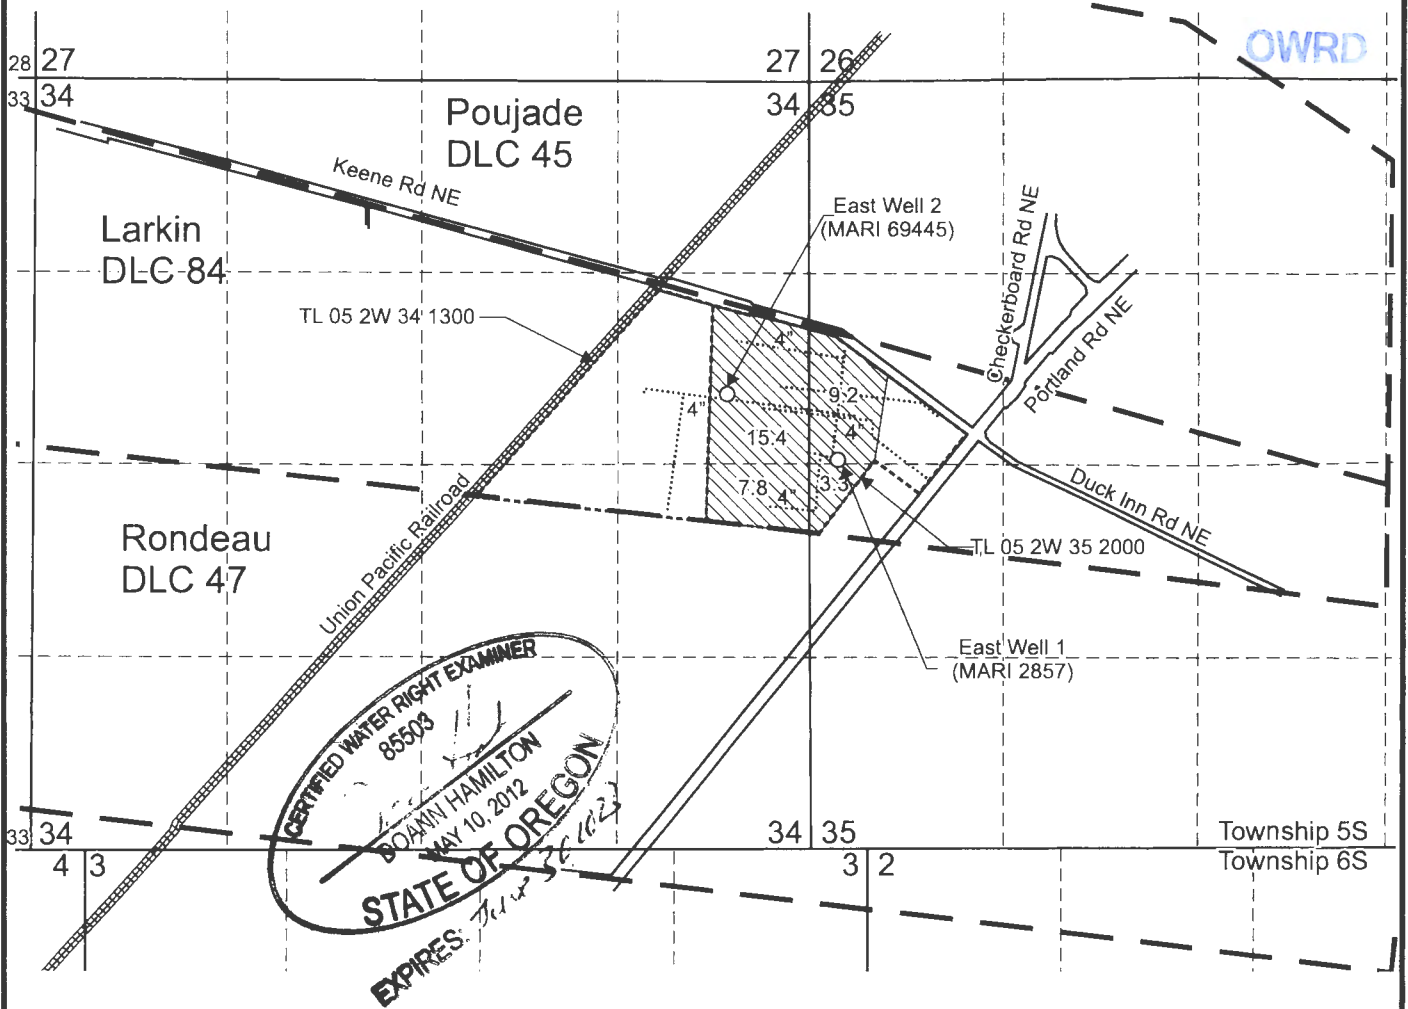

**CERTIFIED WATER RIGHT EXAMINER**  
 85503  
 BOJANNI HAMILTON  
 MAY 10, 2012  
 STATE OF OREGON  
 EXPIRES: 7/1/22

East Well 1 (MARI 2857) is located 2,675 feet north and 180 feet east from the SE corner, Section 34.  
 East Well 2 (MARI 69445) is located 2,145 feet south and 555 feet west from the NE corner, Section 34.

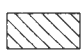 Area (35.7 Acres) of supplemental irrigation under Certificate 54715, priority February 10, 1983, affected by this transfer. (Primary irrigation under GR-898)

----- Tax lot boundary      — — — — — Donation Land Claim boundary      ..... Water main line

Scale: 1" = 1,320'



This map was prepared for the purpose of identifying the location of a water right only and is not intended to provide legal dimensions or location of property ownership lines.



## Claim of Beneficial Use Map T-13087

Pacific Hydro-Geology Inc.

The Scotts Company, LLC  
T.5S. R.2W. Sec. 34 & 35, W.M.

10/2021