


RECEIVED

OCT 15 2018

OWRD

Claim of Beneficial Use Transfer T-11414

A Water Right in the Name of Madison Ranches Land III, LLC
Umatilla County, Oregon
Township 3 North, Range 28 East (W.M.)

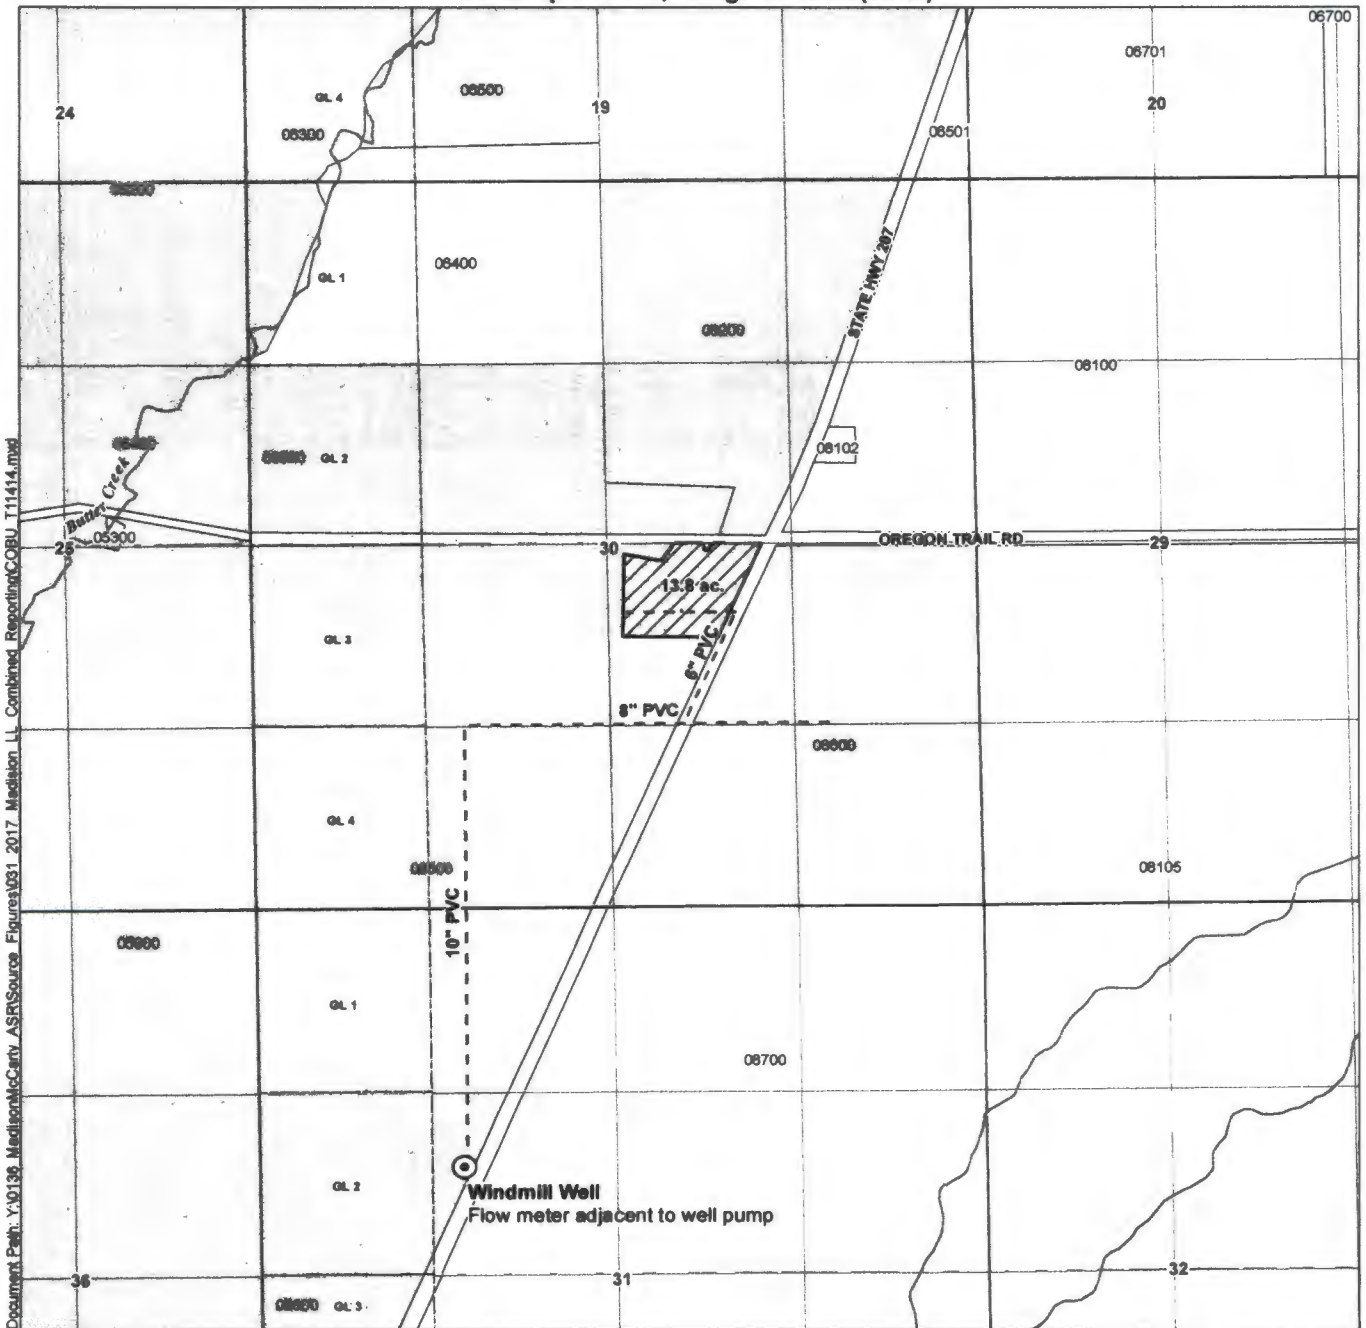

Document Path: Y:\0138_MadisonMcCarty_ASRI\Source_Figures\031_2017_Madison_LL_Combined_Reporting\COBU_T11414.mxd


LEGEND

- Point of Appropriation (POA)
- Water Pipeline
- Piece of Use (POU)
- Government Lot (GL)
- Property Owned by Applicant
- Tax Lot
- Watercourse

POA LOCATION DESCRIPTION

Windmill Well
Located 1620 feet South and 1080 ft West from the North
1/4 corner of Section 31, Township 3 North, Range 28 East

Certified Water Rights Examiner Stamp

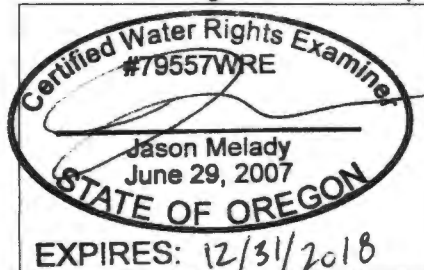

DISCLAIMER

This map was prepared for the purpose of identifying the location of a water right only and it is not intended to provide legal dimensions or location of property ownership lines.

MAP NOTES

Date: August 30, 2018
Data Sources: OWMC, ESRI, BLM, USGS, OGIC

