RECEIVED
NOV 12 2021
OWRD

T.3S. R.3W. Sec. 32 & 33
T.4S. R.3W. Sec. 4 & 5, W.M.

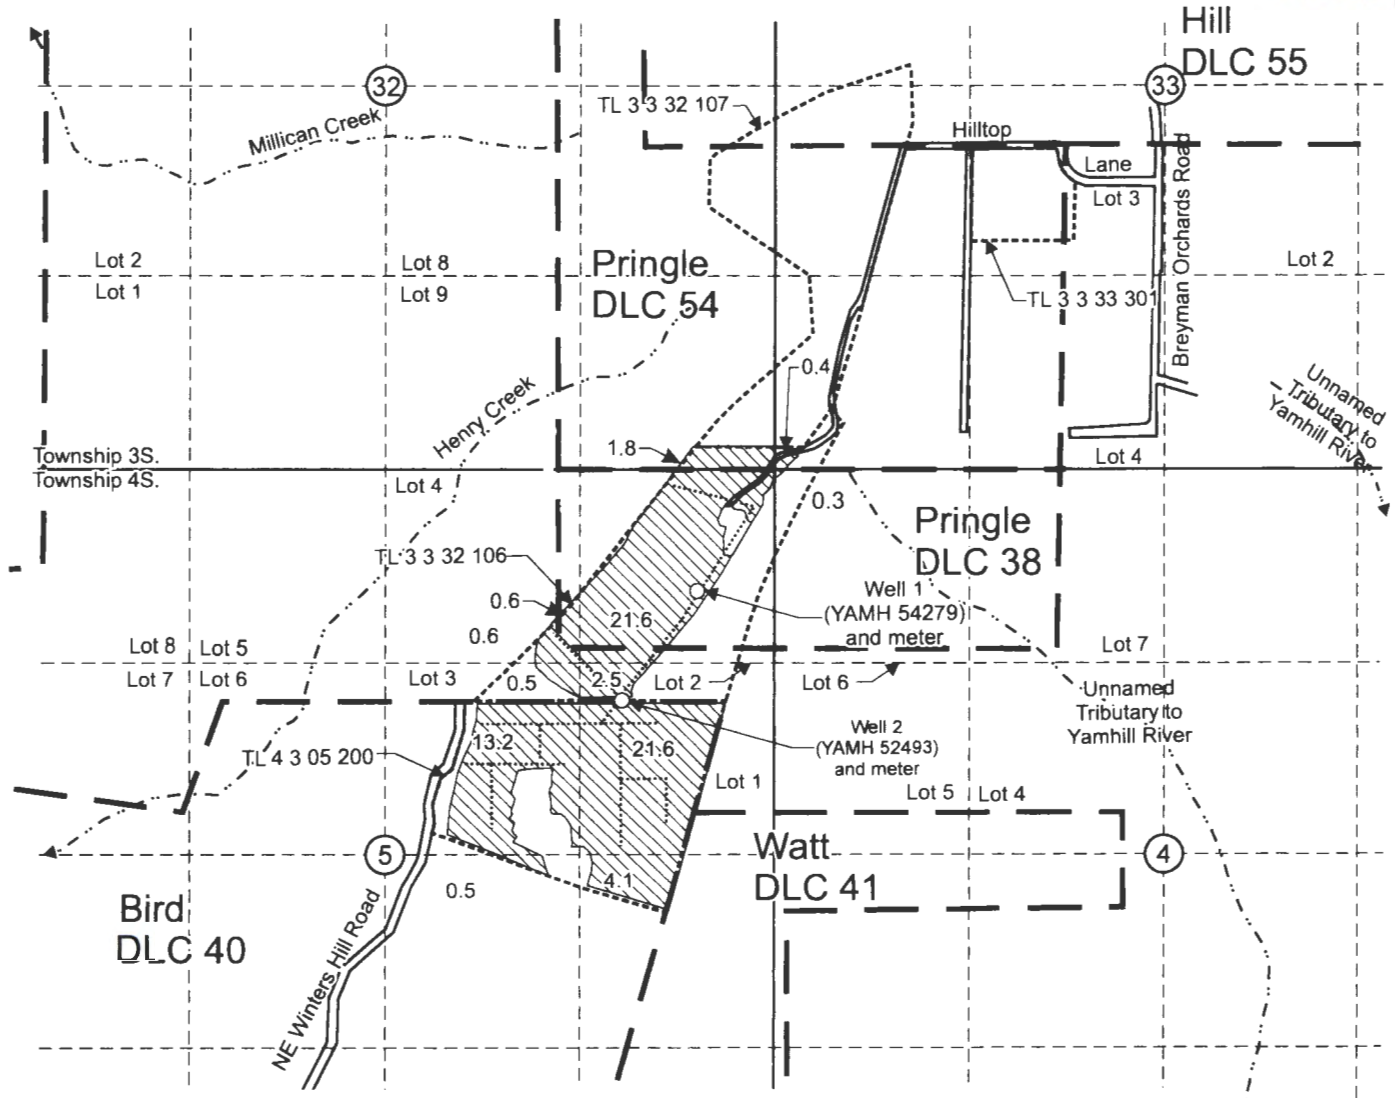

Well 1 (YAMH 54279) is located 830 feet south and 450 feet west from the NE corner, Section 5.

Well 2 (YAMH 52493) located10 feet south and 680 feet west from the NE corner, DLC 40.

Area (67.7 Acres) irrigated under T-13233 formerly Certificate 94264, priority date April 7, 2000.

Donation Land Claim boundary

Tax lot boundary

Irrigation mainlines

CERTIFIED WATER RIGHT EXAMINER
85503
DOANN HAMILTON
MAY 10, 2012
STATE OF OREGON
EXPIRES: June 30 2013

N

Scale: 1" = 1,320'

0 1,320 Feet

This map was prepared for the purpose of identifying the location of a water right only and is not intended to provide legal dimensions or location of property ownership lines.

Claim of Beneficial Use Map
T-13233 formerly Certificate 94264

Humphreys Roepenack Inc.
T.3S. R.3W. Sec. 32 & 33,
T.4S, R.3W. Sec. 4 & 5, W.M.

Pacific Hydro-Geology Inc.

11/2021

WinterT-13233Cert 94264COBUMap.cdr