


T 8 S R 39 E W.M.

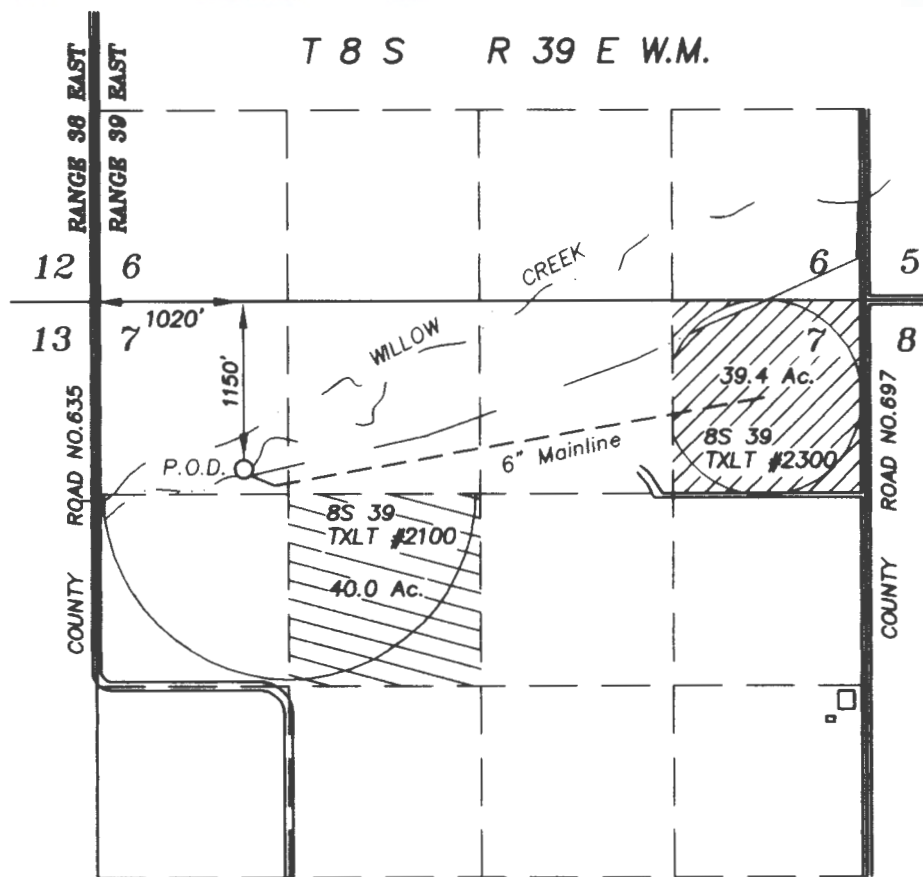

SCALE: 1"=1320'

LEGEND



Lands with supplemental rights under Certificate 38199, now irrigated with Primary rights, Lands with rights under Certificate No. 38198, to be cancelled.



Lands with supplemental rights under Certificate 74063, now irrigated with Primary rights, Lands with rights under Certificate No. 16882, to be cancelled.

RECEIVED

OCT 05 2009

WATER RESOURCES DEPT
SALEM, OREGON

SEPTEMBER 22, 2009

**FINAL PROOF MAP
FOR CHANGE IN
CHARACTER OF USE
FOR**

KERNS RAINBOW RANCH INC.

SITE SURVEY: September 29, 2008



This map is for the purpose of identifying the water right location only and is not intended to provide legal dimensions or location of property ownership lines.

APPLICATION NO. T- 9997

PERMIT NUMBER T- 9997

HANLEY ENGINEERING INC.
2043 MAIN STREET
BAKER CITY, OREGON