
FINAL PROOF SURVEY
UNDER
TRANSFER 12148
SPECIAL ORDER 107-1036

RECEIVED

SEP 2 2 2020

OWRD

IN NAMES OF LLOYD C. BANSEN FAMILY, LLC JACKI L. GROFF

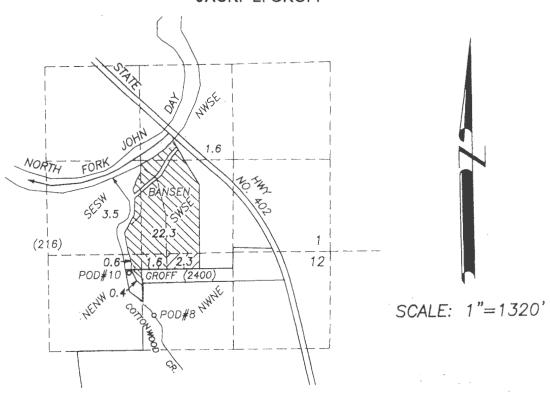

BANSEN

O POD #8: 4515' NORTH & 2770' EAST FROM SW COR. SEC. 12, MEASURING DEVICE & FISH SCREEN STRUCTURE BEARS N 19 W., 166 FT.

GROFF

POD #10: PUMP, FLOWMETER & FISH SCREEN 5020' NORTH & 2440' EAST FROM SW COR. SECTION 12

) TAX LOT

TI TI

0

TRACT 1: PRIMARY COTTONWOOD CREEK PRIORITY DATE: JUNE 7, 1983



TRACT 2: PRIMARY COTTONWOOD CREEK SUPP. NORTH FK. JOHN DAY RIVER PRIORITY DATE JUNE 7, 1983

FD. BRASS CAP AT SW COR, SEC. 12

PREPARED BY
ROBERT D. BAGETT, PLS, CWRE
217 N. CANYON BLVD.
JOHN DAY, OR 97845
AUGUST 28, 2020



RENEWS 12/31/2021