


# CLAIM OF BENEFICIAL USE MAP

TO CHANGE PLACE OF USE AND POINT OF APPROPRIATION  
FOR TRANSFER APPLICATION T-12386

LOCATED IN SECTION 23,  
TOWNSHIP 34 SOUTH, RANGE 19 EAST, W.M.  
TAX LOT: 200

RECEIVED  
SIC  
C.D.

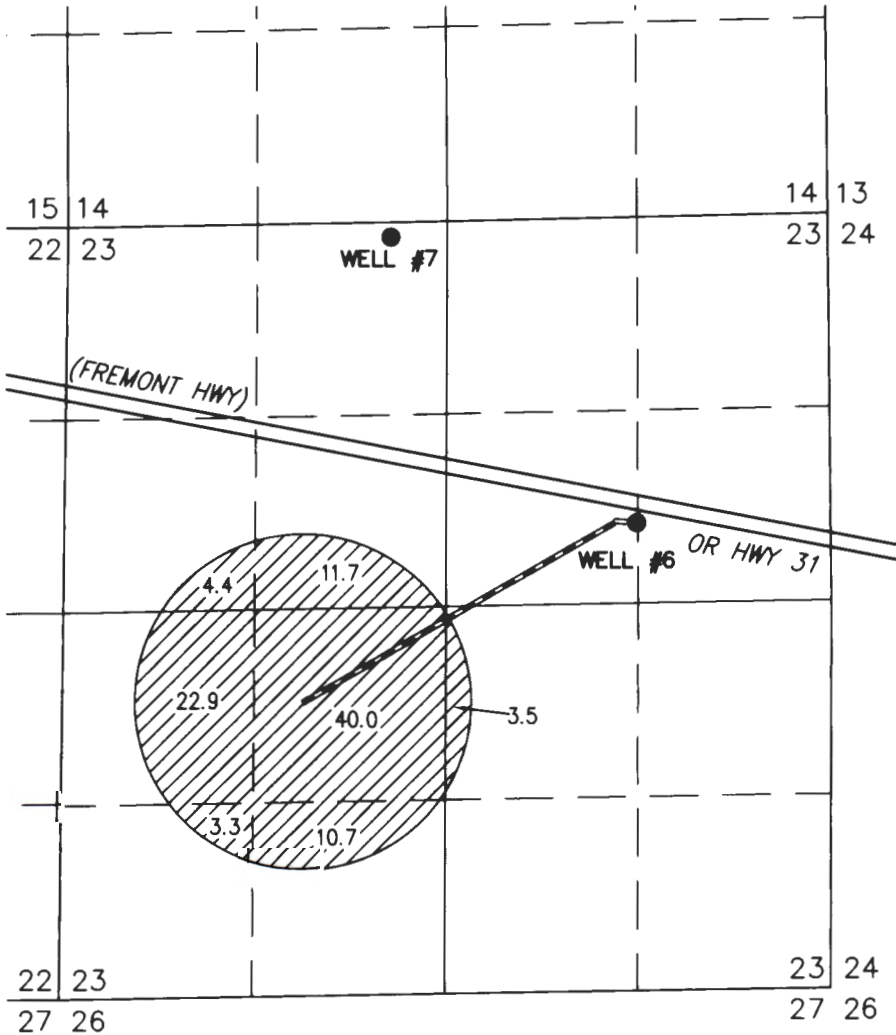

 96.5 ACRES IR FROM POA 6 PER T-12386, AS SHOWN.

● WELL #6 (LAKE 1719) IN THE SW 1/4 NE 1/4 SECTION 23, T34S R19E, W.M. LOCATED 570.9 FEET NORTH AND 1332.8 FEET WEST FROM THE E 1/4 CORNER OF SECTION 23. FLOW METER IS LOCATED 10' WEST FROM THE WELL.



RENEWAL DATE: 12/31/2020

THIS MAP IS FOR THE PURPOSE OF LOCATING A WATER RIGHT ONLY AND HAS NO INTENT TO PROVIDE LEGAL DIMENSIONS OR THE LOCATION OF PROPERTY LINES

PREPARED FOR:

JRS PROPERTIES III LLLP  
P.O. BOX 27  
BOISE, ID 83707

PREPARED BY:



ALL POINTS ENGINEERING AND SURVEYING, INC.  
P.O. BOX 767 TERREBONNE, OR 97760  
(541) 548-5833  
www.APEandS.com