


CLAIM OF BENEFICIAL USE MAP

TO CHANGE PLACE OF USE AND POINT OF APPROPRIATION
FOR TRANSFER APPLICATION T-12386

LOCATED IN SECTIONS 14 & 23,
TOWNSHIP 34 SOUTH, RANGE 19 EAST, W.M.
TAX LOT: 200

REC'D
SI 08

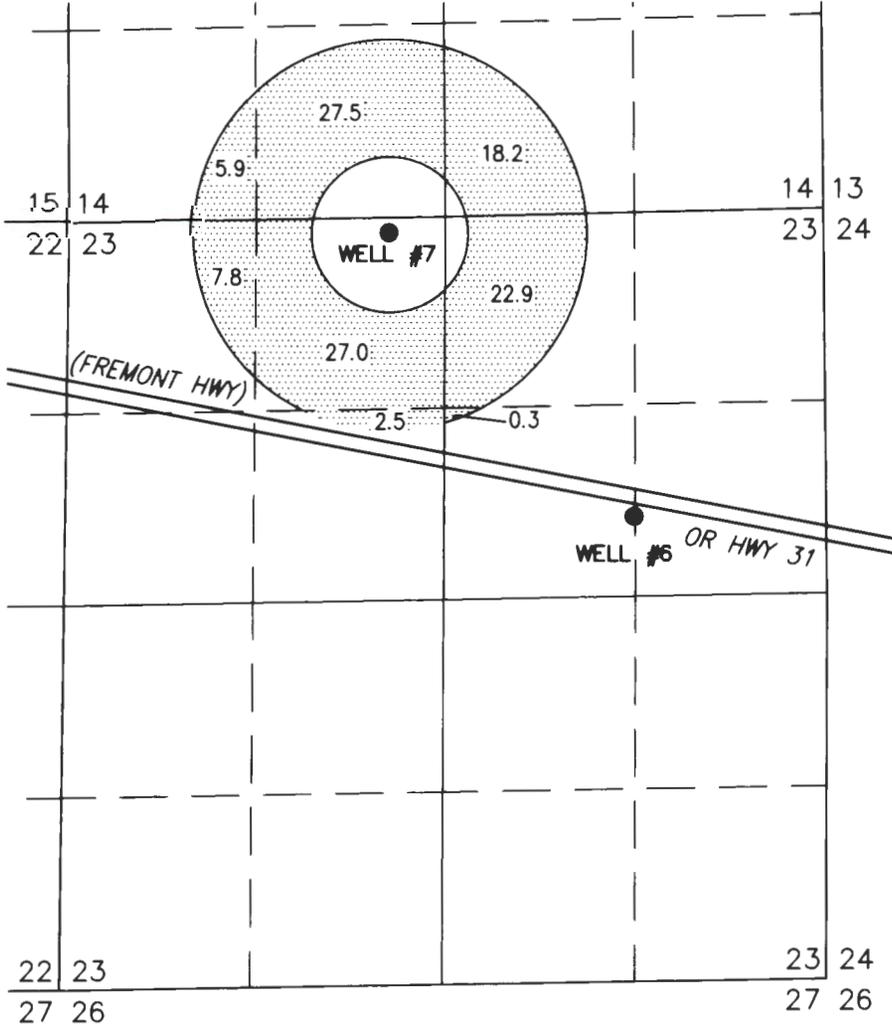

RENEWAL DATE: 12/31/2020

 112.1 ACRES IR FROM POA 7 PER T-12386, AS SHOWN.

THIS MAP IS FOR THE PURPOSE OF LOCATING A WATER RIGHT ONLY AND HAS NO INTENT TO PROVIDE LEGAL DIMENSIONS OR THE LOCATION OF PROPERTY LINES

● WELL #6 (LAKE 1719) IN THE SW 1/4 NE 1/4 SECTION 23, T34S R19E, W.M. LOCATED 570.9 FEET NORTH AND 1332.8 FEET WEST FROM THE E 1/4 CORNER OF SECTION 23. FLOW METER IS LOCATED 10' WEST FROM THE WELL.

● WELL #7 (LAKE 52463) IN THE NE 1/4 NW 1/4 SECTION 23, T34S R19E, W.M. LOCATED 105 FEET SOUTH AND 3000 FEET WEST FROM THE NE CORNER OF SECTION 23. FLOW METER IS LOCATED 6 FEET WEST FROM THE WELL.

PREPARED FOR:

JRS PROPERTIES III LLLP
P.O. BOX 27
BOISE, ID 83707

PREPARED BY:



ALL POINTS ENGINEERING AND SURVEYING, INC.
P.O. BOX 767 TERREBONNE, OR 97760
(541) 548-5833 www.APEandS.com