



TOWNSHIPS 10 & 11 SOUTH, RANGES 20 & 21 EAST, W.M.

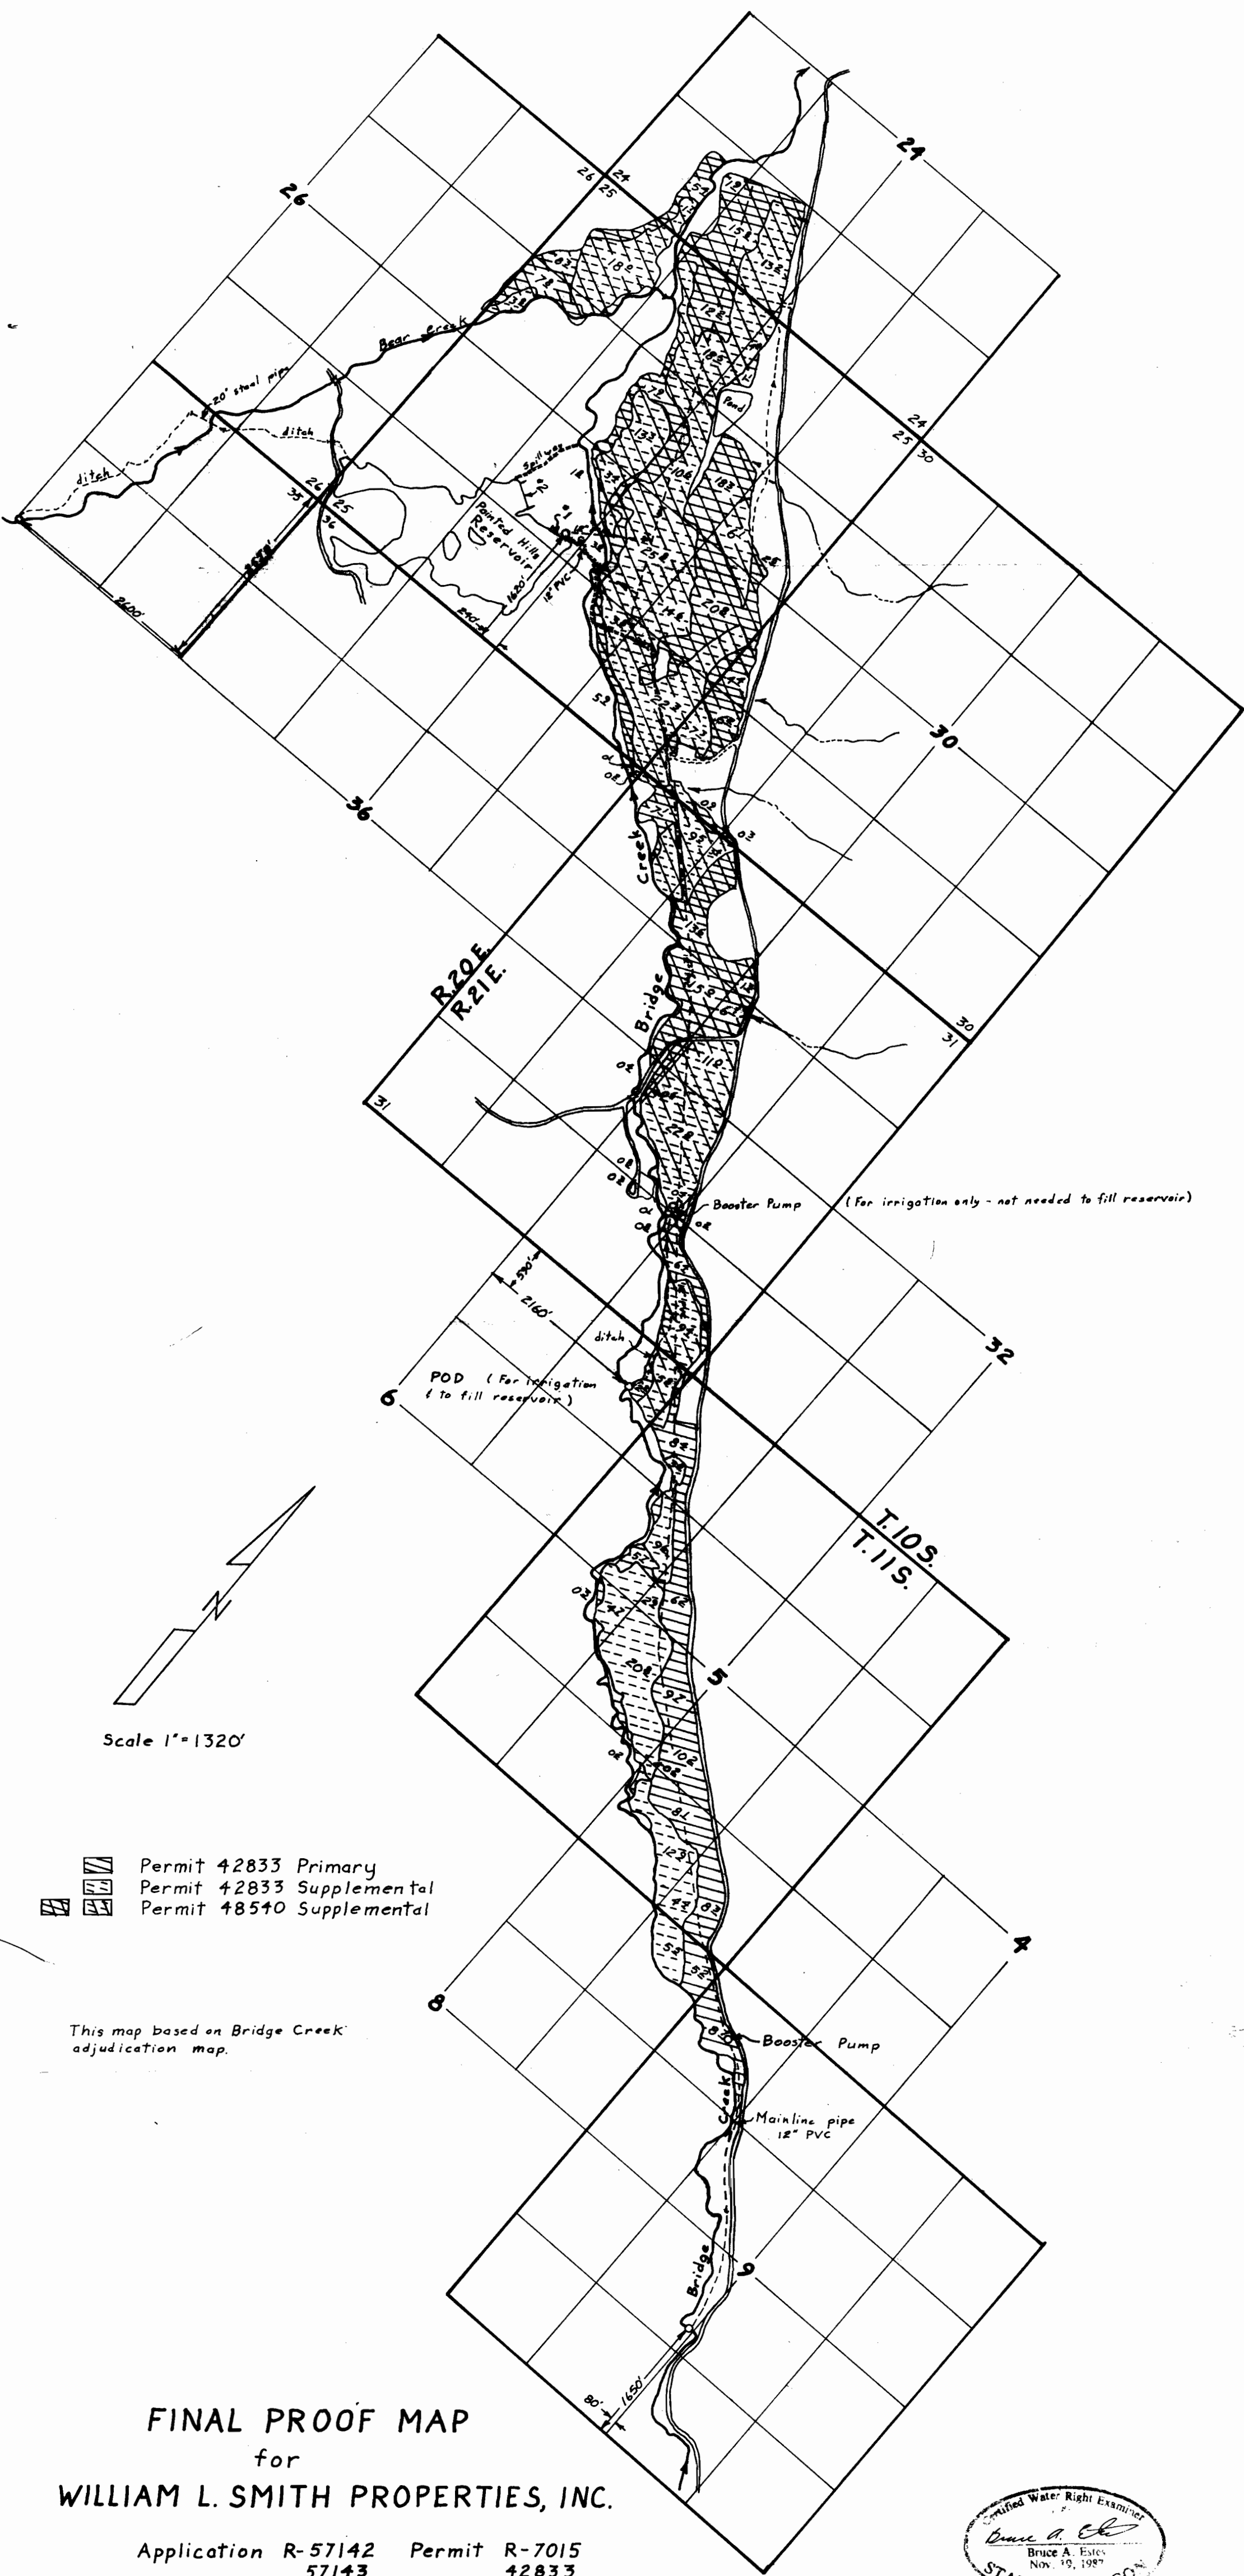

FINAL PROOF MAP
for
WILLIAM L. SMITH PROPERTIES, INC.



Application R-57142 Permit R-7015
57143 42833
R-67960 R-9896
67961 48540

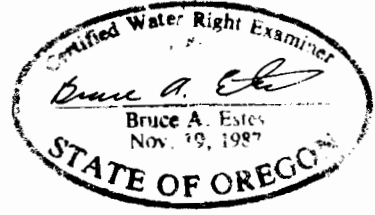

This map is for the purpose of locating a water right only and has no intent to provide legal dimensions or the location of property lines.

POD Transfer (C68553)

CERTIFIED WATER RIGHT EXAMINER
72665
Gabe M. Williams
GABRIEL M. WILLIAMS
JULY 10, 2018
STATE OF OREGON
RENEWS: 6/30/22

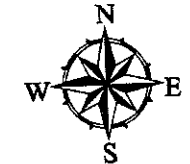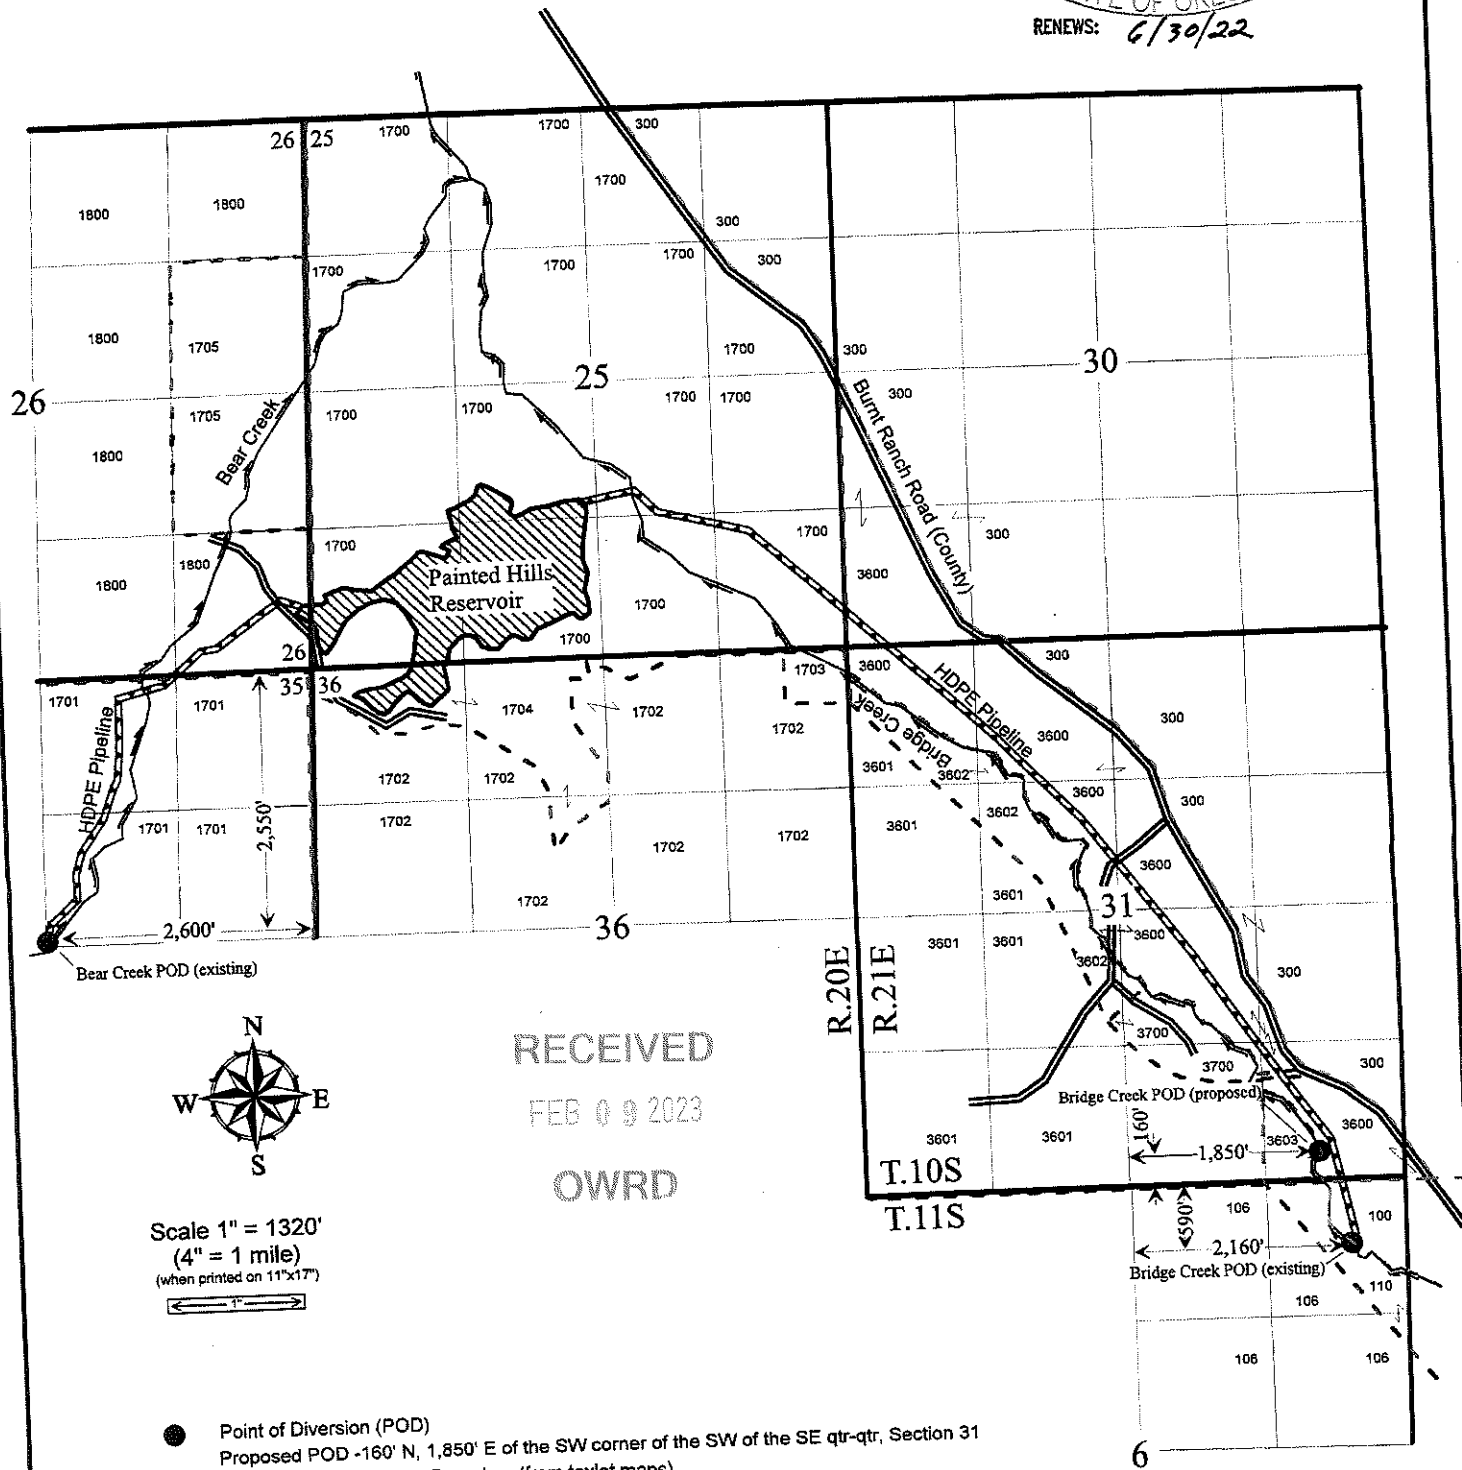

Scale 1" = 1320'
(4" = 1 mile)
(when printed on 11"x17")

- Point of Diversion (POD)
Proposed POD - 160' N, 1,850' E of the SW corner of the SW of the SE qtr-qtr, Section 31
- - - Approximate Ownership Boundary (from taxlot maps)
- == Pipeline
- == Road
- Creek

This map is for the purpose of locating a water right only and is not intended to provide legal dimensions or locations of property ownership lines.


RECEIVED
FEB 09 2023
OWRD

RECEIVED
OWRD

S6 - 1.1	DRAWING: DRAWN BY: GMM	SHEET TITLE: Transfer Map	PROJECT: Transfer Map Cert 68553	PROJECT LOCATION: MITCHELL, OREGON	CLIENT: Bridge Creek Ranch, LLC	RSI Resource Specialists Inc. 1180 SW LAKE RD, STE 202 REDMOND, OR 97756 (541) 771-6911 gabe@RSIengr.com	DRAWING STATUS	DATE	No.	REVISION	DATE
							DRAFT	8/30/21			
							FINAL	9/28/21			

POD Transfer (C68553)

CERTIFIED WATER RIGHT EXAMINER
72665
Gabe M. Williams
GABRIEL M. WILLIAMS
JULY 10, 2018
STATE OF OREGON

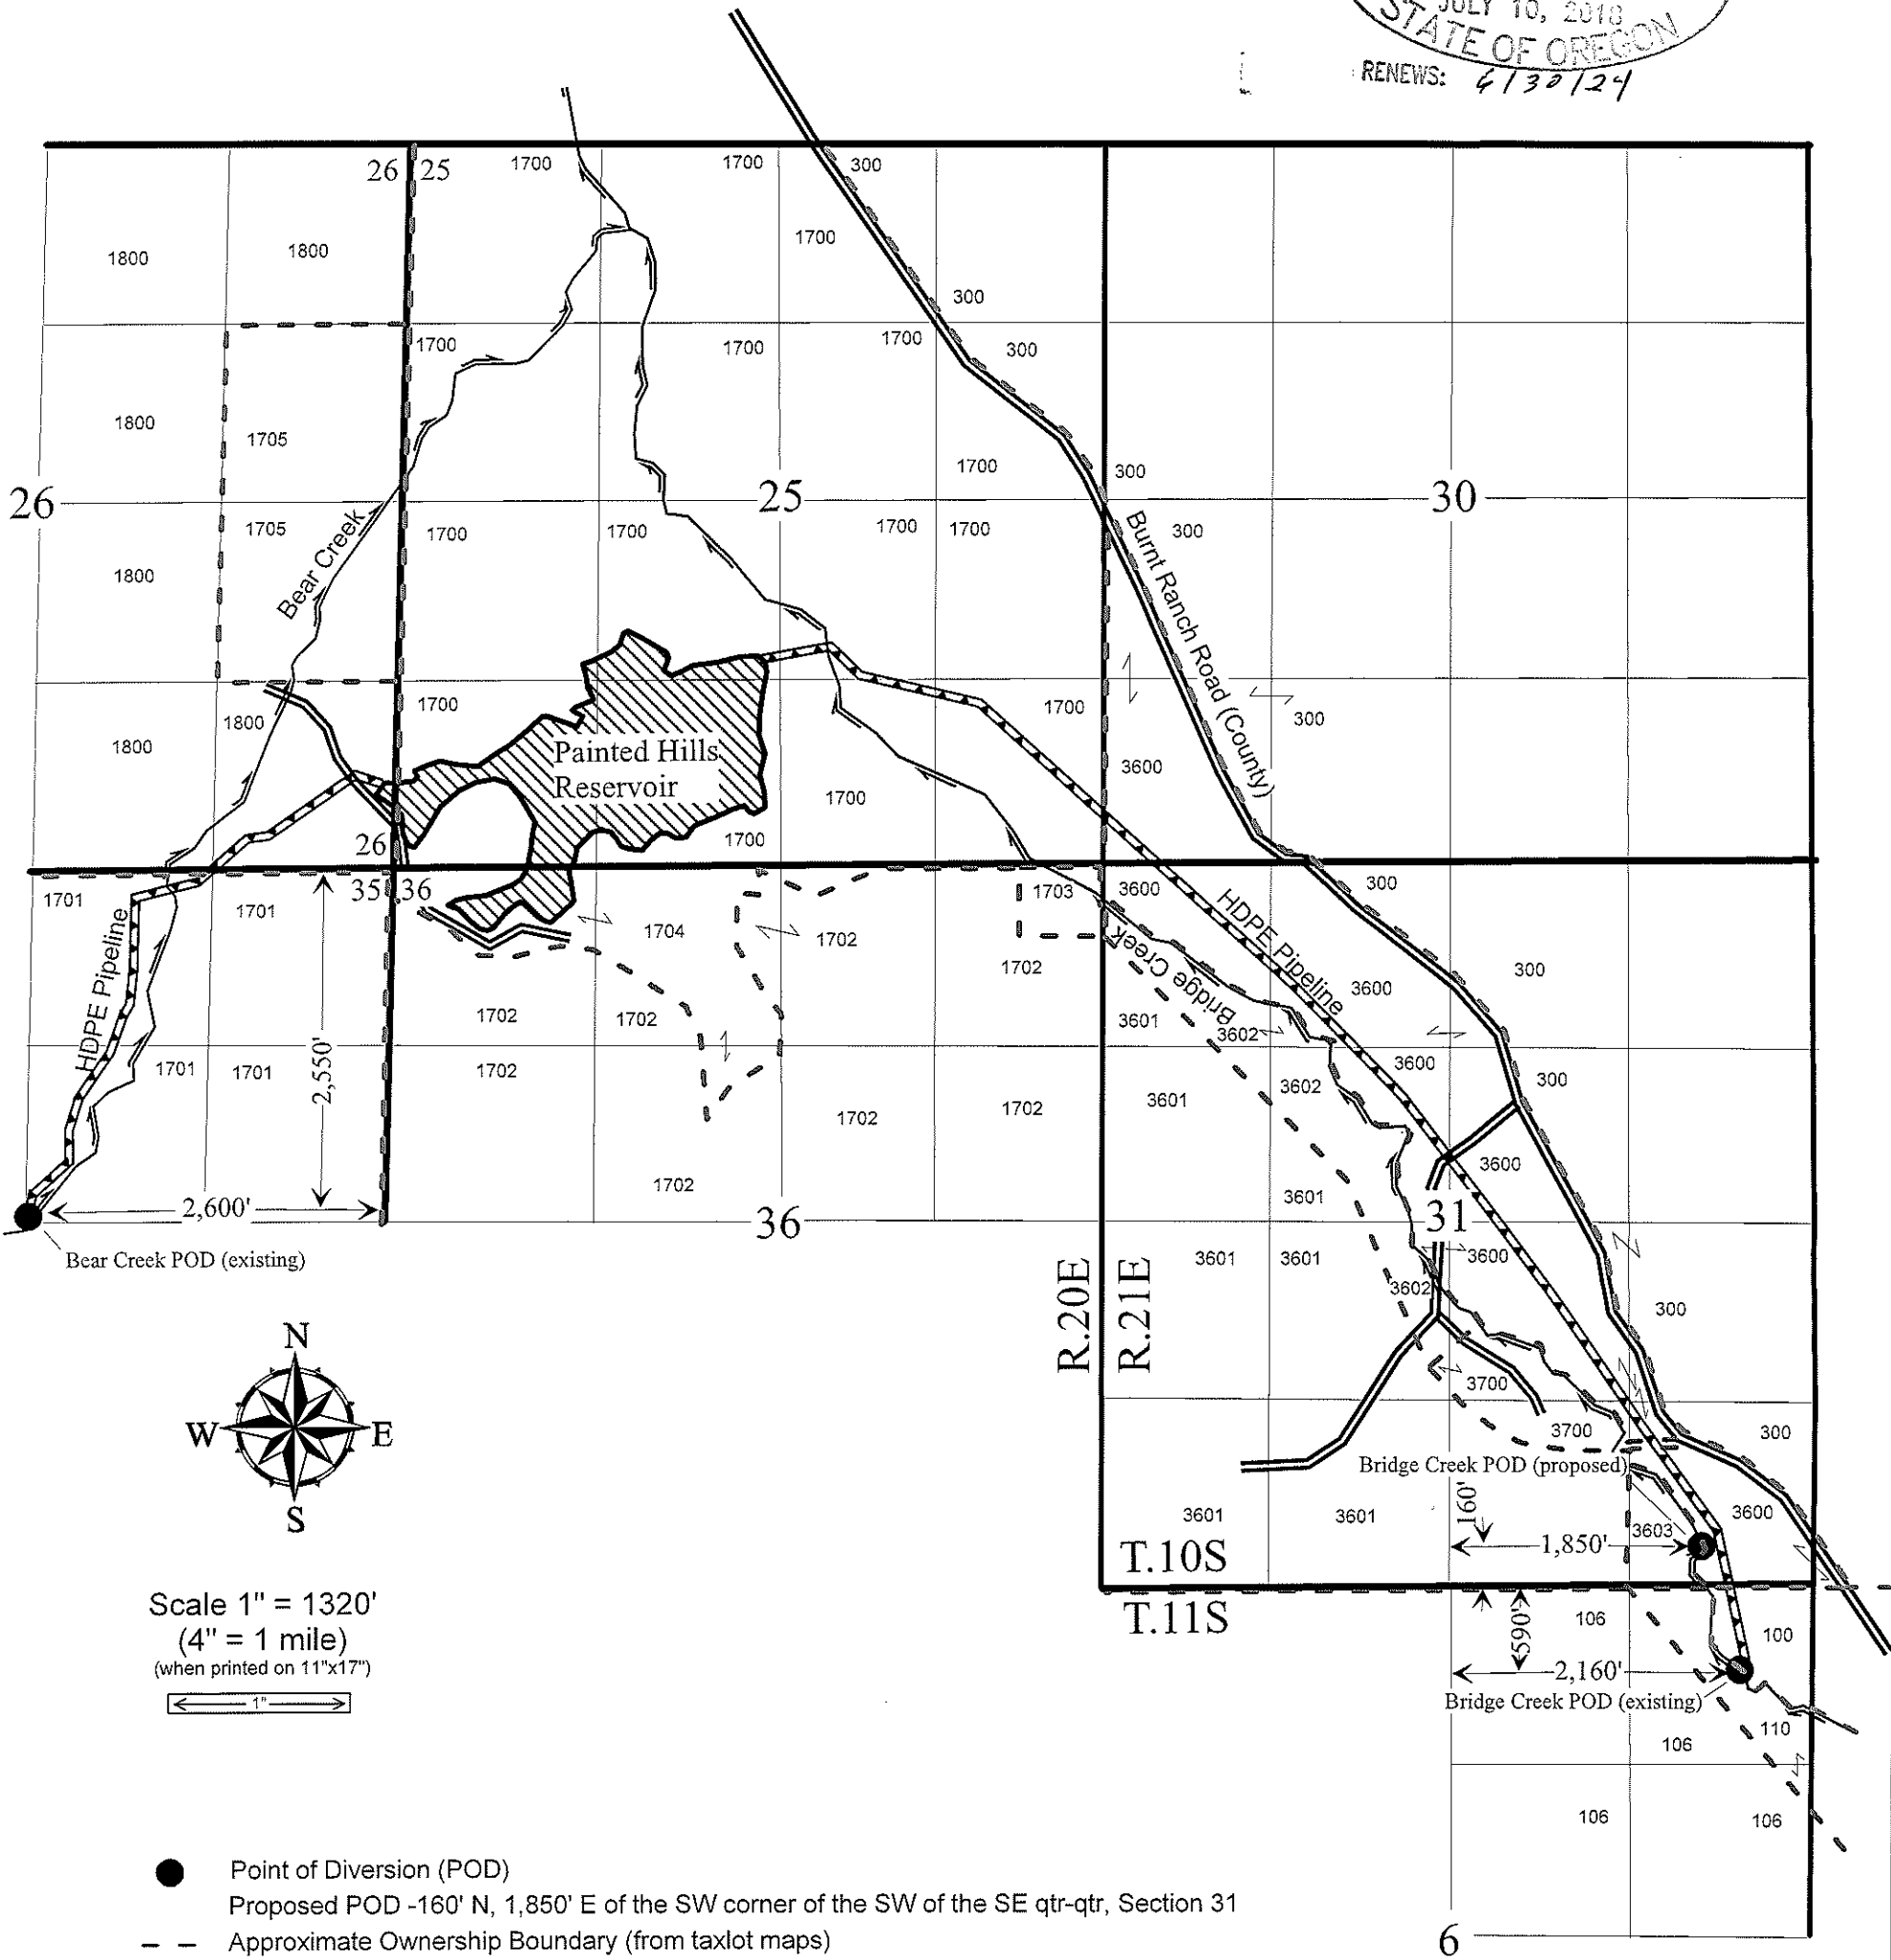

This map is for the purpose of
locating a water right only
and is not intended to provide
legal dimensions or locations
of property ownership lines.

RECEIVED

FEB 09 2023

OWRD

S6 - 1.1

DRAWN BY: GMM
SHEET TITLE:
Transfer Map

PROJECT:
Transfer Map Cert 68553

PROJECT LOCATION:
MITCHELL, OREGON

CLIENT:
Bridge Creek Ranch, LLC

RSI Resource Specialists INC.

1180 SW LAKE RD, STE 202 (541) 771-6911
REDMOND, OR 97756 gabe@RSIengr.com

DRAWING STATUS	DATE	No.	REVISION	DATE
DRAFT	8/30/21			
FINAL	9/28/21			