T.6S. R.1&2W. Section 7, 12, & 13, W.M.

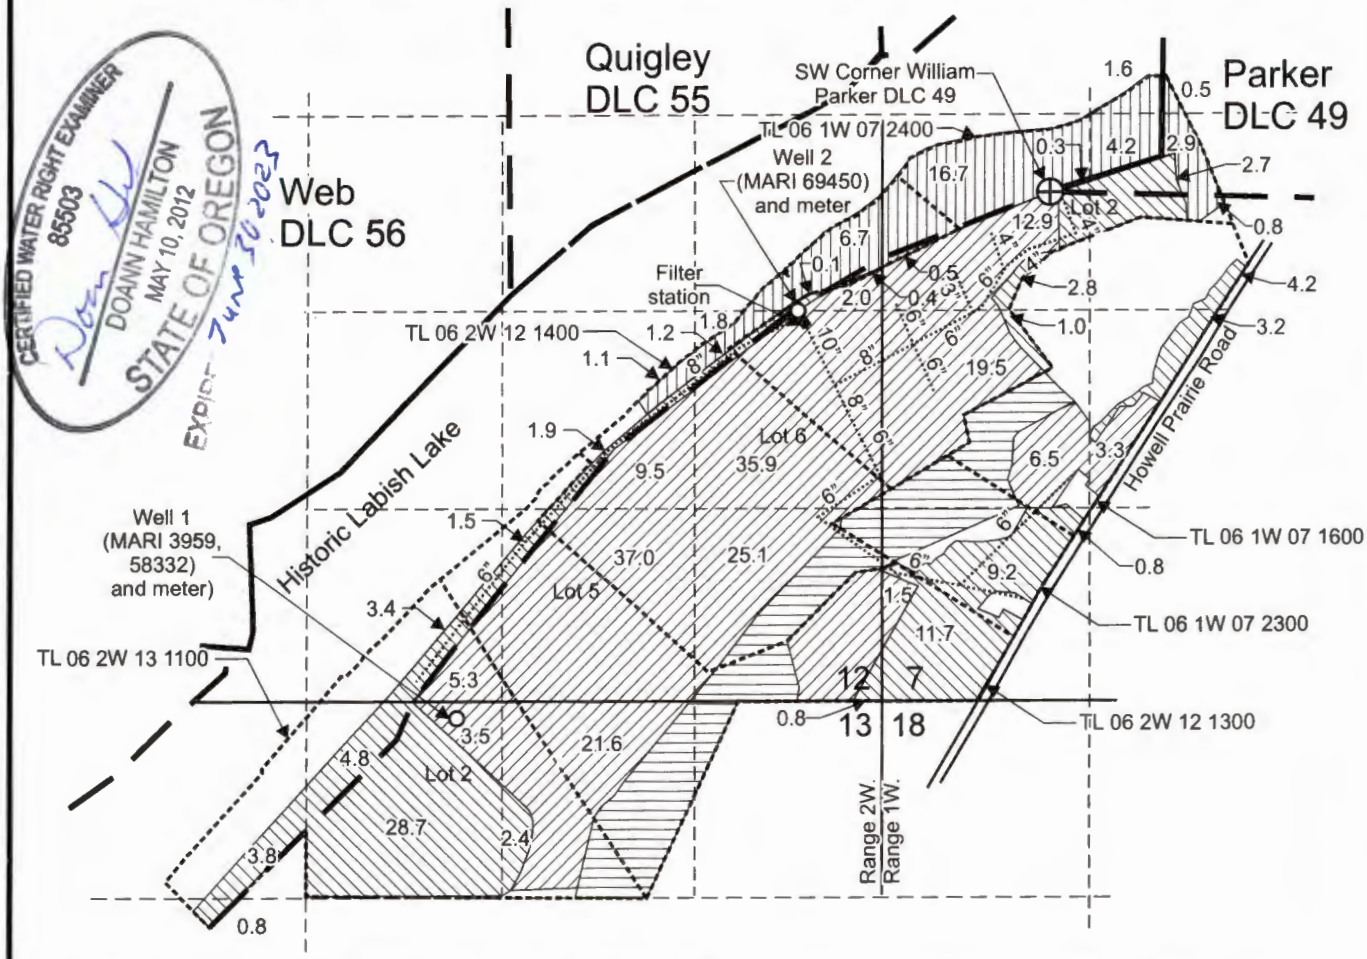

Well 1 (MARI 3959, 58332) is located 115 feet south and 2,925 feet west from the NE corner, Section 13.

Well 2 (MARI 69450) is located 800 feet south and 1,690 feet west from the SW corner, William Parker DLC 49.

Area (85.3 acres) primary irrigation under Application G-15722, Permit G-15990.

Area (37.2 acres) of primary irrigation area on NRCS easement under Application G-15722, Permit G-15990.

Area (183.6 acres) of supplemental irrigation under Application G-15722, Permit G-15990.

NRCS easement within supplemental irrigation area under Application G-15722, Permit G-15990, not irrigated.

Tax lot boundary

Donation Land Claim boundary

Water main line (buried and above ground)

N

This map was prepared for the purpose of identifying the location of a water right only and is not intended to provide legal dimensions or location of property ownership lines.

Scale: 1" = 1,320'

0 1,320 Feet

Claim of Beneficial Use Map
Application G-15722, Permit G-15990, T-10412

Pacific Hydro-Geology Inc.

Wagenbach PNW LLC / Stor-Moore LLC,
Joseph Cox and Hilary Rich

10/2022

WagenbachCOBUMap.cdr

RECEIVED
NOV 1 0 2022
OWRD