



RECEIVED

APR 11 2022



OWRD

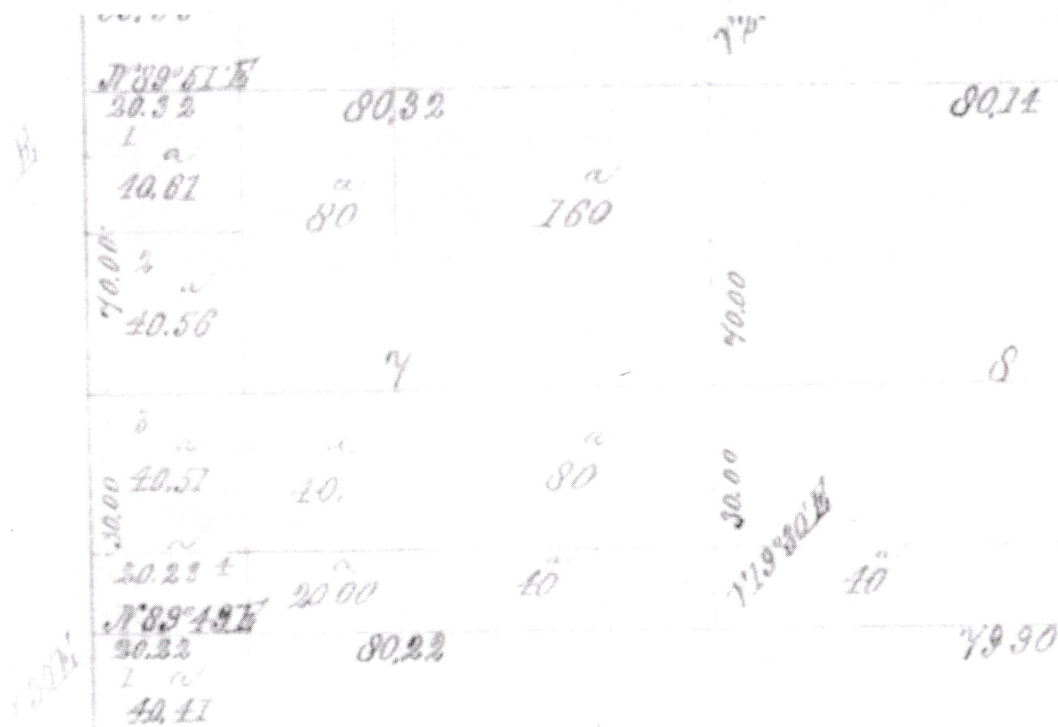

13973

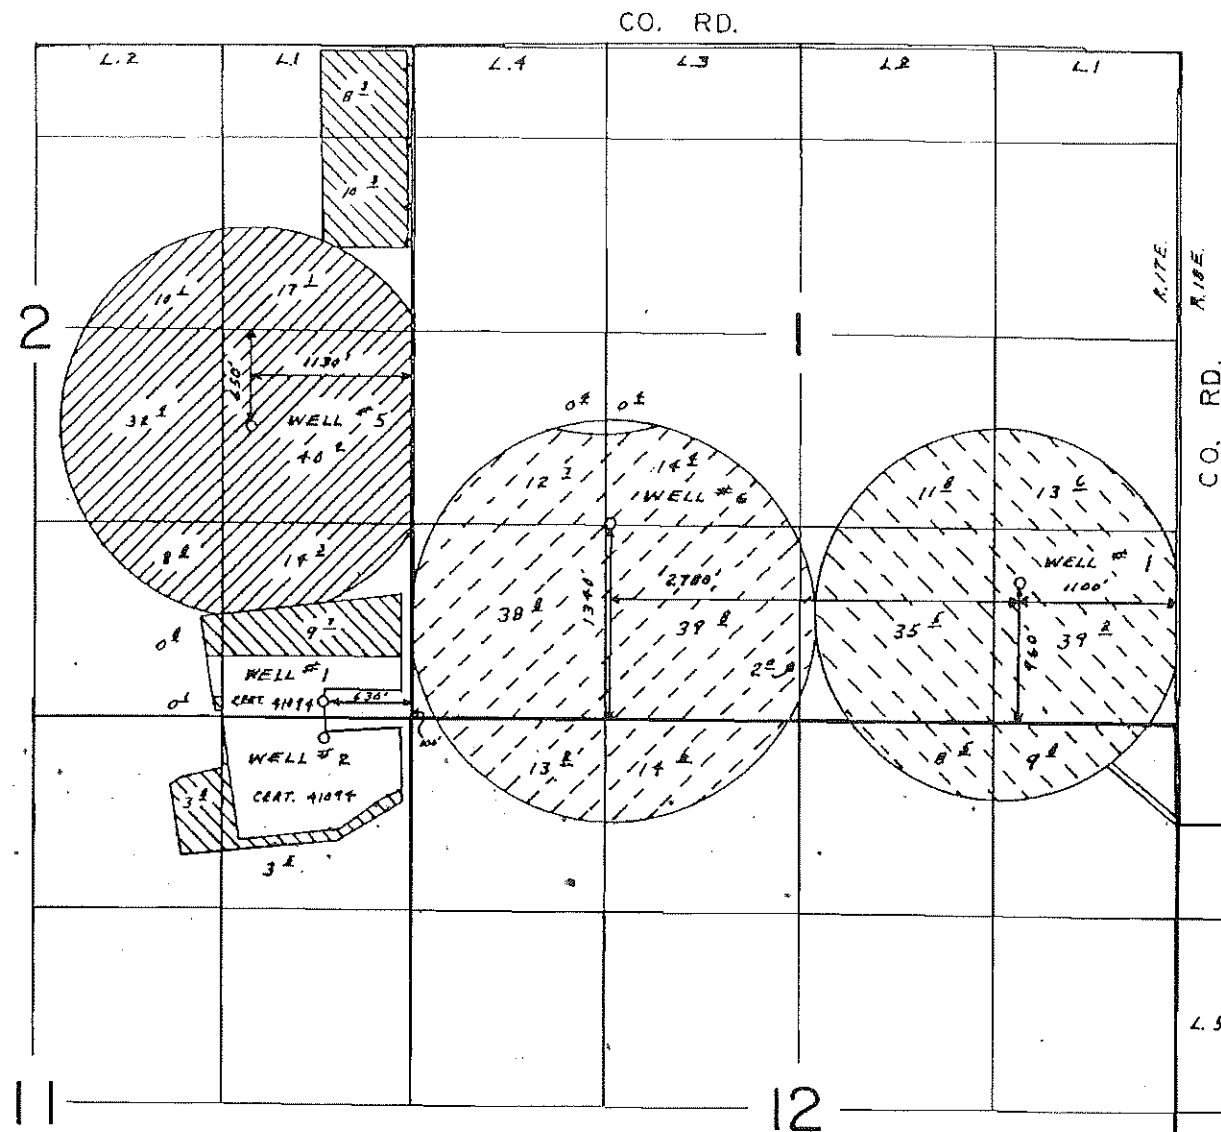

SCALE: 1"=1320'

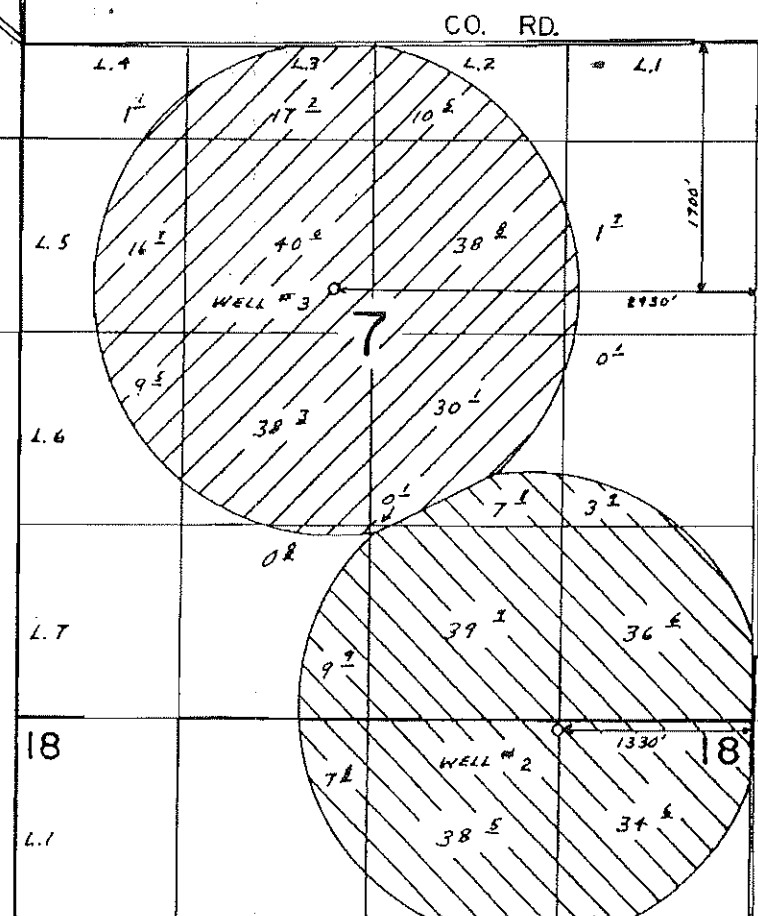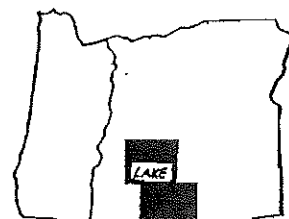

T.25 S., R.17 & 18 E., W.M.

- G-9261 WELL #5
- G-7841 WELL #1
- G-6530 WELL #6
- G-9261 WELL #1
- G-9261 WELL #3
- G-9261 WELL #2

FINAL PROOF SURVEY UNDER

G-7043 G-6530
G-7174 G-7841
Application No. G-10068 Permit No. G-9261
IN NAME OF

DAVID & GALYN ROTH

Surveyed AUG. 31 1988 by B. BISHOP

RECEIVED

APR 11 2022

OWRD

13973

1-19-89
d.c.



PTS 11-1988

KEEP IN FILE G-10068

MAP TO ACCOMPANY WATER
RIGHT TRANSFER APPLICATION
FOR
DANIEL ROTH

SECTIONS 3, 7 & 18, TOWNSHIP 25 SOUTH,
RANGE 18 EAST, W.M.
LAKE COUNTY, OREGON

TOWNSHIP 25 SOUTH,
RANGE 18 EAST, W.M.

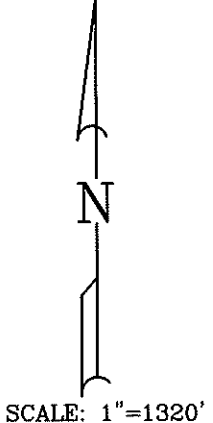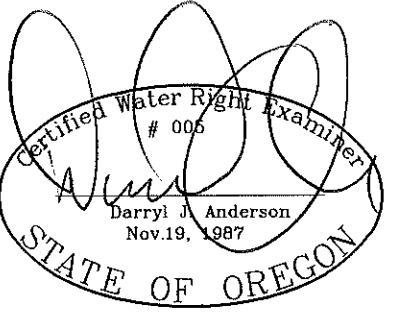


- LEGEND**
- SECTION LINE
 - 1/4 SECTION LINE
 - 1/16 SECTION LINE
 - TAXLOT LINE

TRANSFER NO. _____

RECEIVED
APR 11 2022
OWRD

NOTE:
PREPARATION OF THIS MAP IS FOR IDENTIFYING PROPOSED
WATER RIGHTS ONLY. IT HAS NO INTENT TO PROVIDE
LOCATIONS OR DIMENSIONS OF PROPERTY BOUNDARIES.

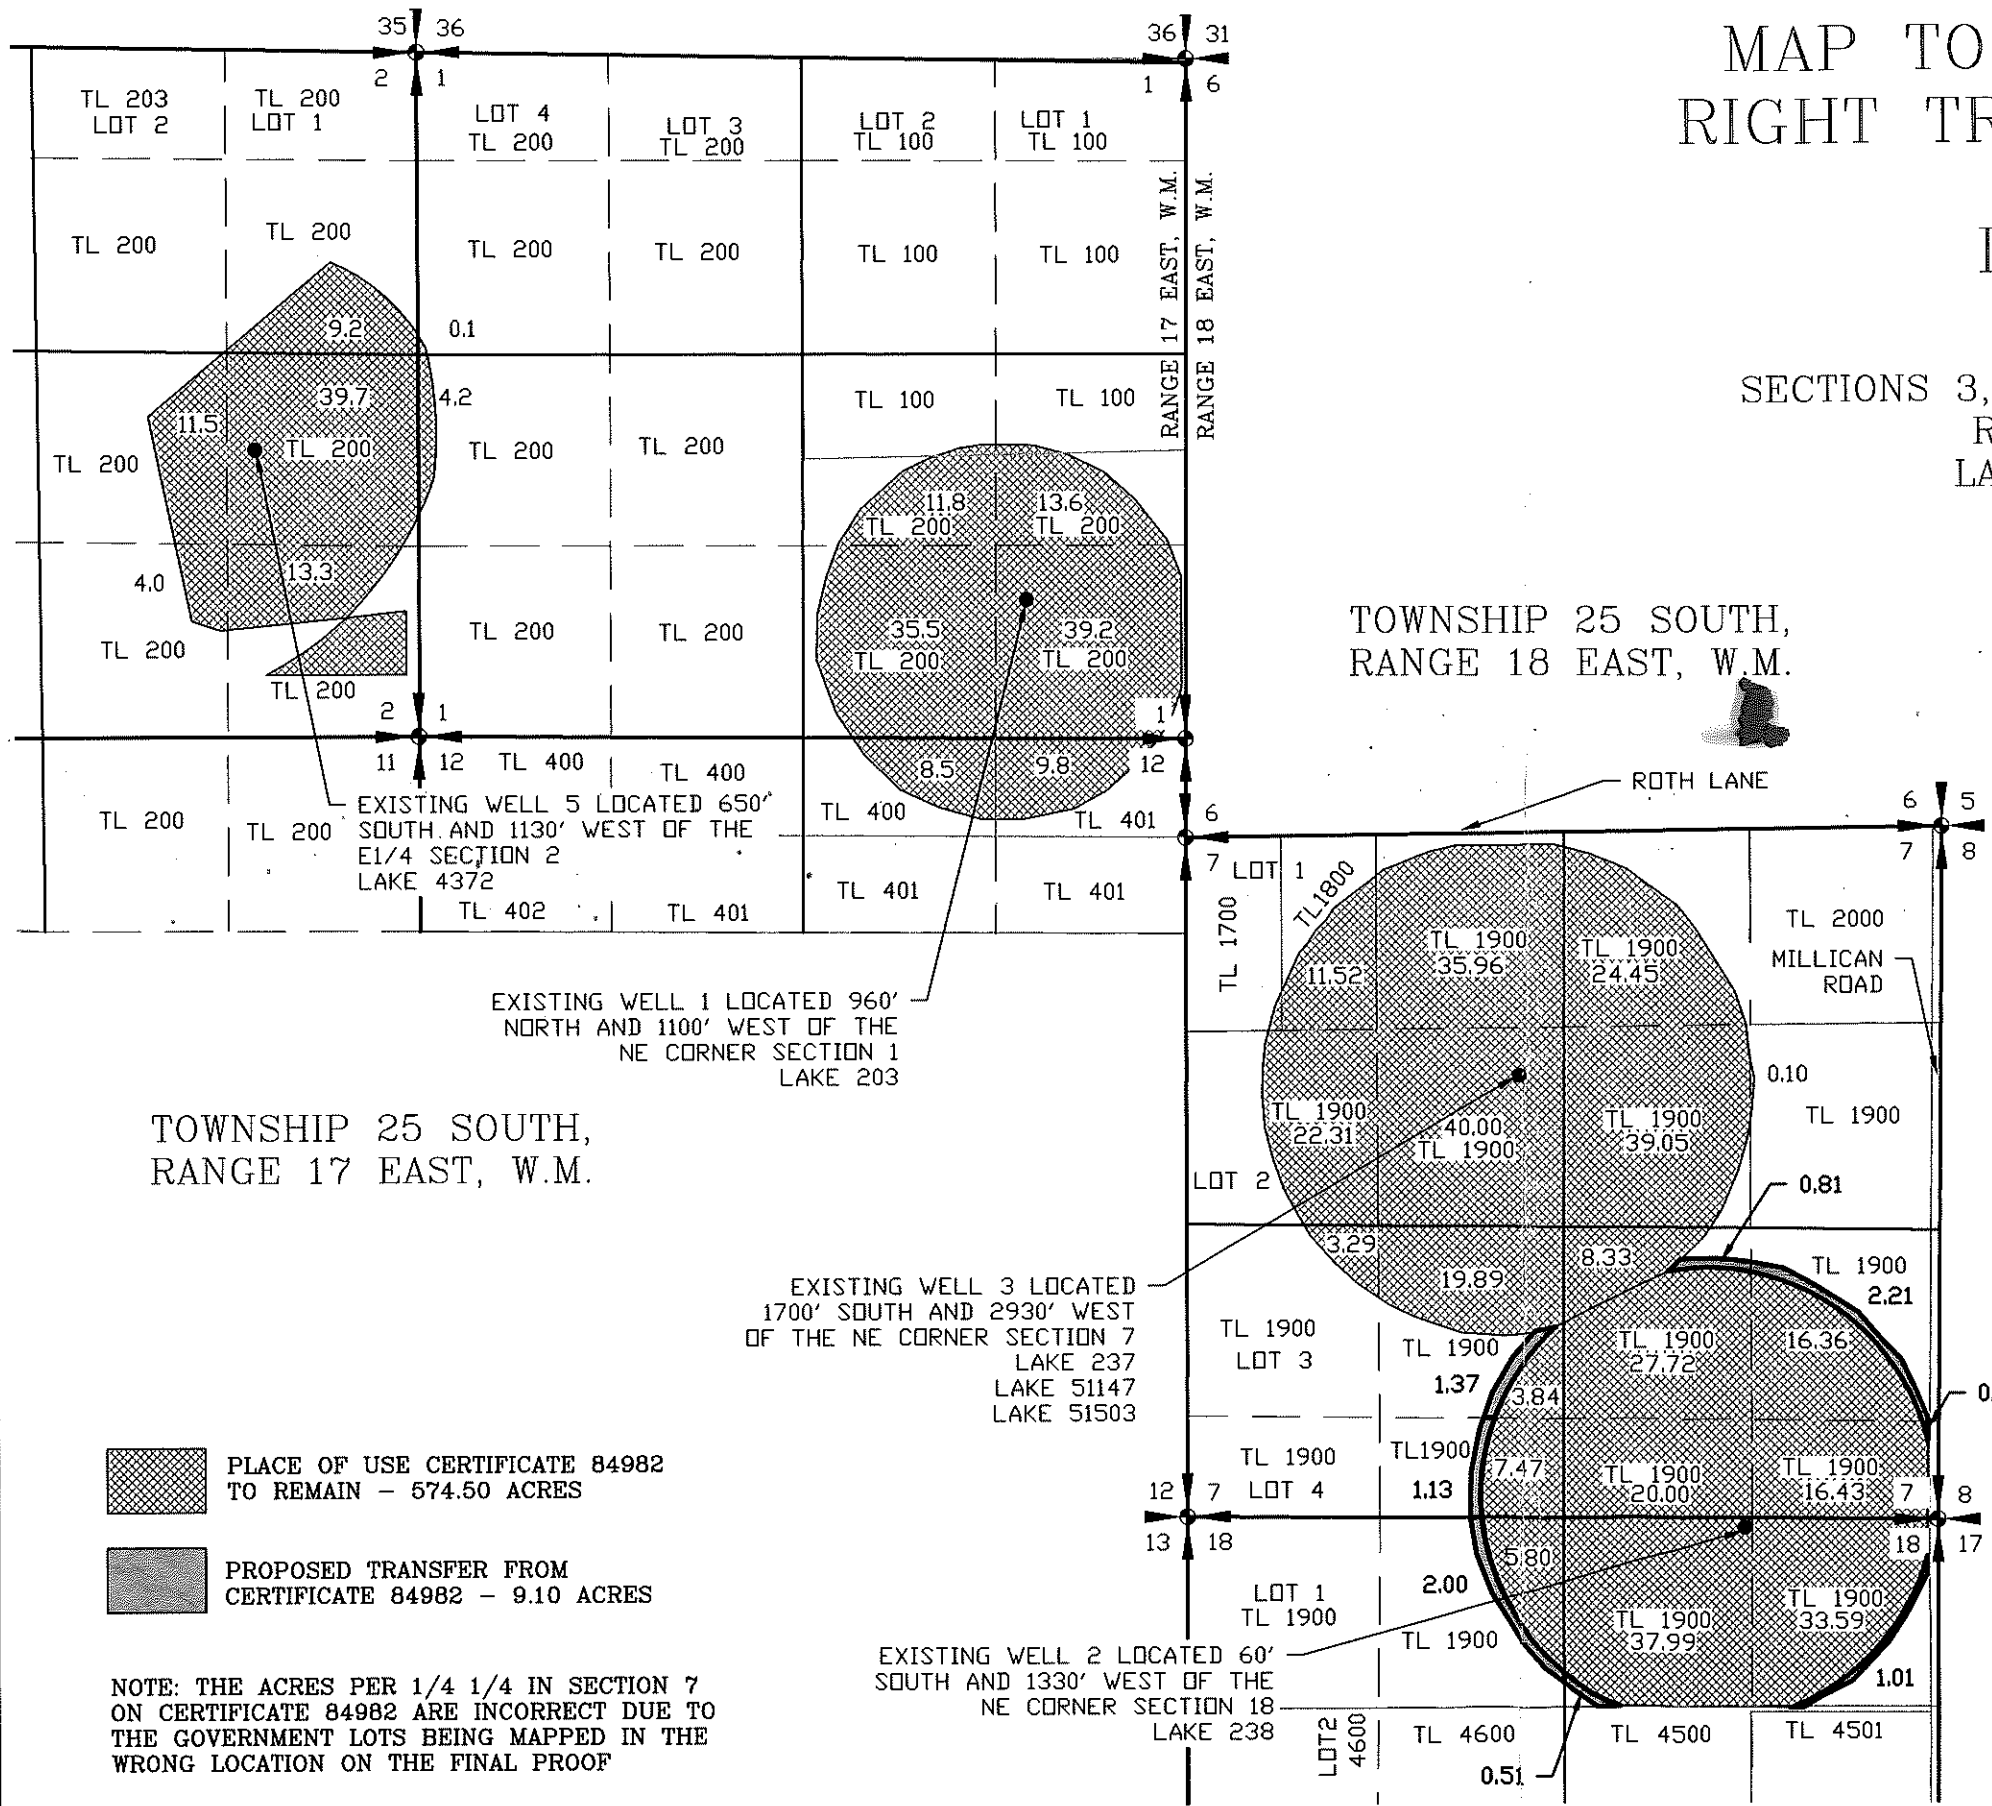

TOWNSHIP 25 SOUTH,
RANGE 17 EAST, W.M.

- PLACE OF USE CERTIFICATE 84982
TO REMAIN - 574.50 ACRES
- PROPOSED TRANSFER FROM
CERTIFICATE 84982 - 9.10 ACRES



NOTE: THE ACRES PER 1/4 1/4 IN SECTION 7
ON CERTIFICATE 84982 ARE INCORRECT DUE TO
THE GOVERNMENT LOTS BEING MAPPED IN THE
WRONG LOCATION ON THE FINAL PROOF

EXISTING WELL 3 LOCATED
1700' SOUTH AND 2930' WEST
OF THE NE CORNER SECTION 7
LAKE 237
LAKE 51147
LAKE 51503

EXISTING WELL 2 LOCATED 60'
SOUTH AND 1330' WEST OF THE
NE CORNER SECTION 18
LAKE 238

EXISTING WELL 1 LOCATED 960'
NORTH AND 1100' WEST OF THE
NE CORNER SECTION 1
LAKE 203

EXISTING WELL 5 LOCATED 650'
SOUTH AND 1130' WEST OF THE
E1/4 SECTION 2
LAKE 4372

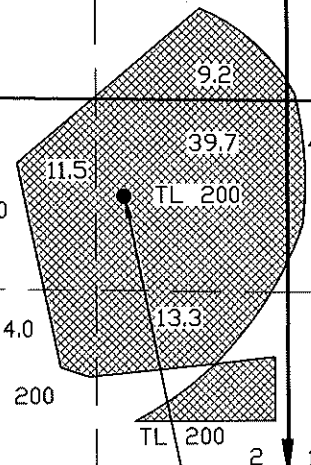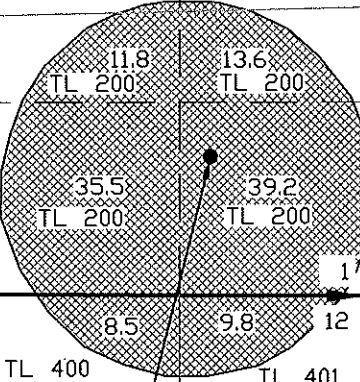

13973

REVISION	BY

**ANDERSON ENGINEERING
AND SURVEYING, INC.**
P.O. BOX 28
LAKEVIEW, OREGON 97630
(541) 947-4407/FAX: 947-2321
WWW.ANDERSONENGINEERING.COM


FOR:
DWIGHT ROTH
P.O. BOX 107
CHRISTMAS VALLEY, OR
97641

MAP TO ACCOMPANY WATER
RIGHT TRANSFER APPLICATION
SEC. 3, 7 & 18, T25S, R18E W.M.

DATE:	1/31/2022
SCALE:	1" = 1320'
DWG. BY:	R.C.
JOB:	2022-008
FILE:	2022-008
SHEET:	1 OF 3

FOR
DANIEL ROTH

SECTIONS 3, 7 & 18, TOWNSHIP 25 SOUTH,
RANGE 18 EAST, W.M.
LAKE COUNTY, OREGON

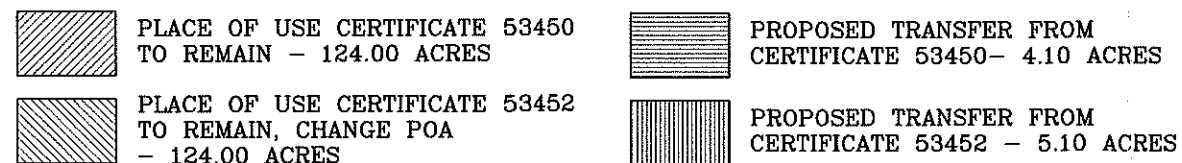

N

SCALE: 1"=1320'

_____ SECTION LINE
 _____ 1/4 SECTION LINE
 _____ 1/16 SECTION LINE
 _____ TAXLOT LINE

TRANSFER NO.

OVERD

REVISION	BY

LAKEVIEW, OREGON 97630
(541) 947-4407/FAX: 947-2321
WWW.ANDERSONENGINEERING.COM

FOR:
DWIGHT ROTH
P.O. BOX 107
CHRISTMAS VALLEY, OR
97641

MAP TO ACCOMPANY WATER
RIGHT TRANSFER APPLICATION
SEC. 3, 7 & 18, T25S, R18E W.M.

DATE:	1/31/2022
SCALE:	1" = 1320'
DWG. BY:	R.C.
JOB:	2022-008
FILE:	2022-008
SHEET:	2 OF 3

