

NOTES

1. This map was prepared for the purpose of identifying the location of water rights only and is not intended to provide legal dimensions or locations of property ownership lines.


CLAIM OF BENEFICIAL USE MAP

Located in the NW-SE Qtr-Qtr
of Section 16
T.13S., R.9E., W.M.
Jefferson County

16


SW-NE

NW-SE

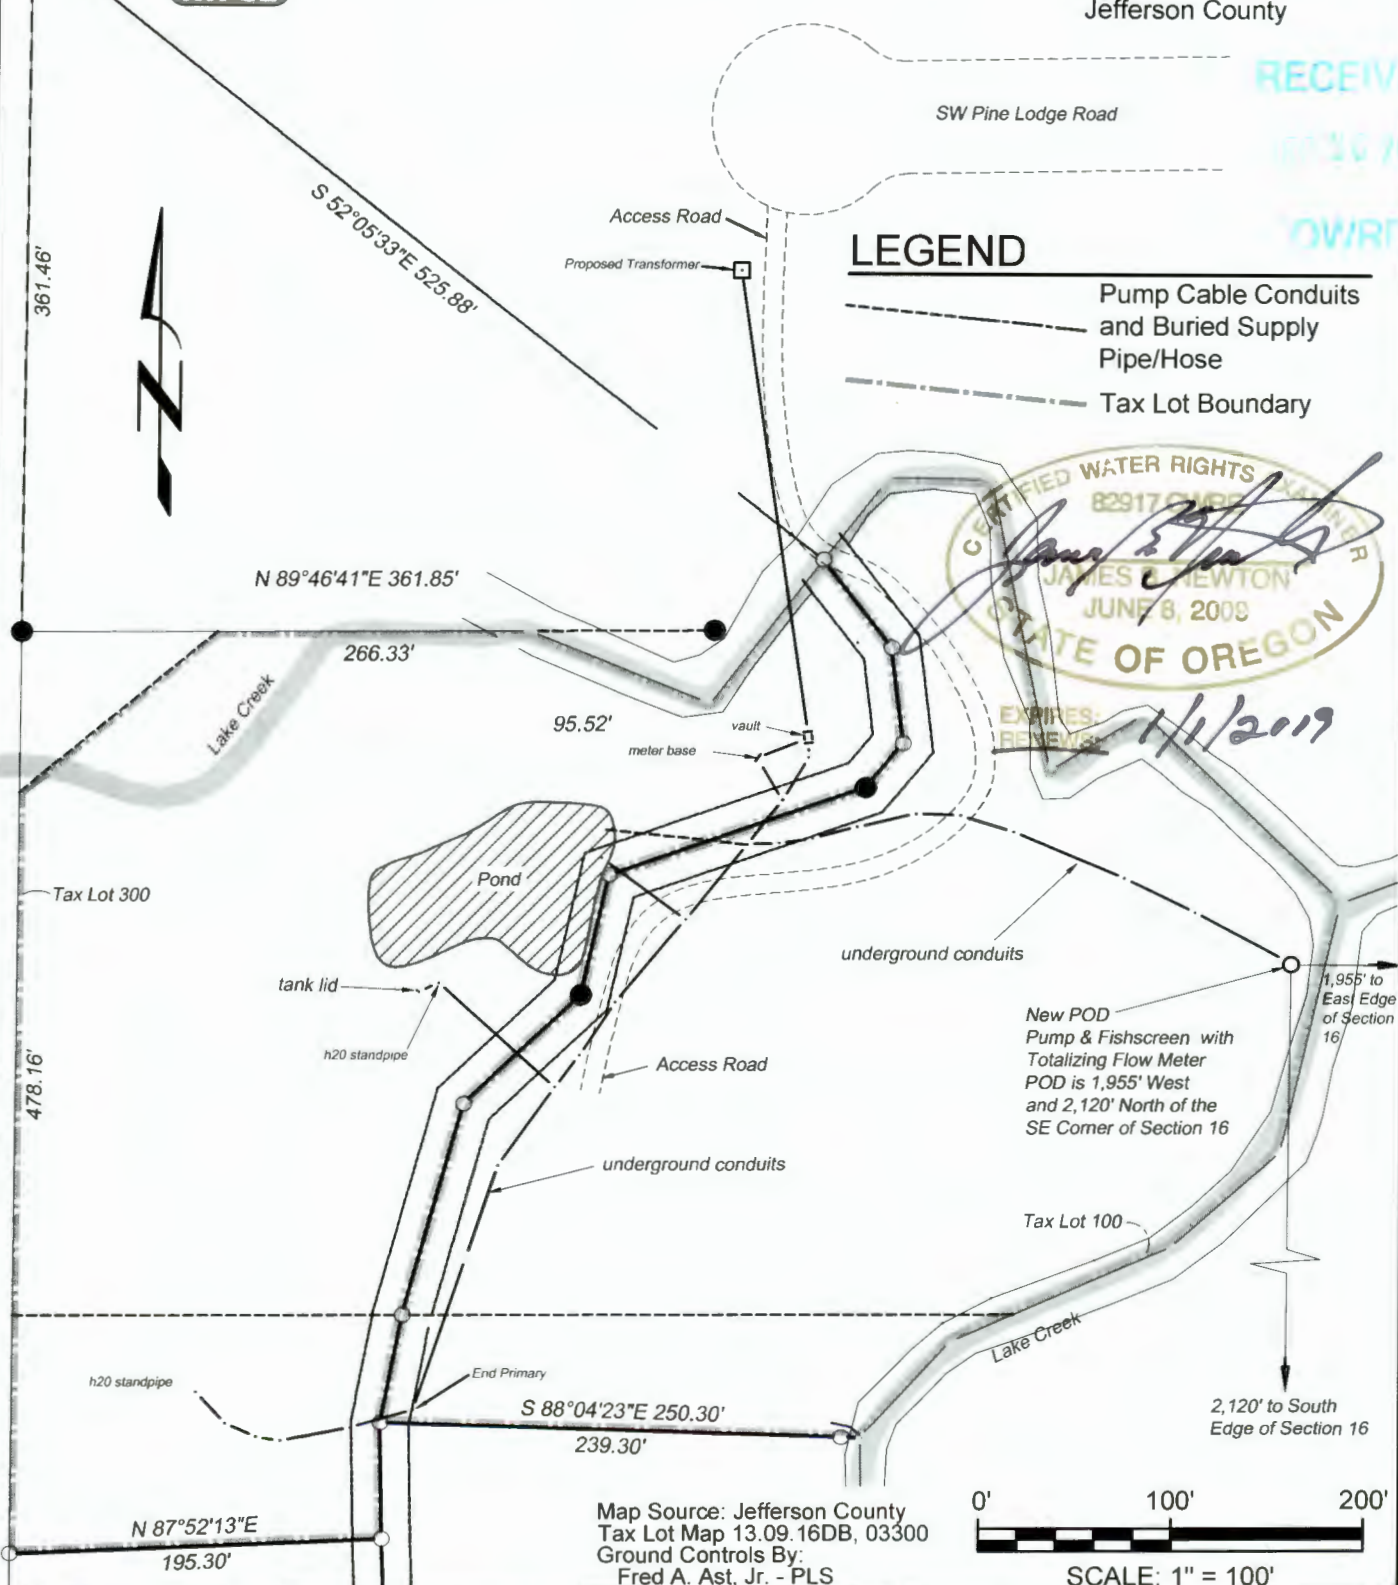


LEGEND

- Pump Cable Conduits and Buried Supply Pipe/Hose
- Tax Lot Boundary

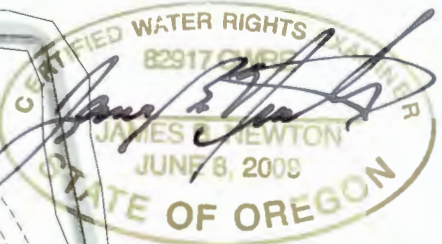

EXPIRES: 1/1/2019
RENEWAL:

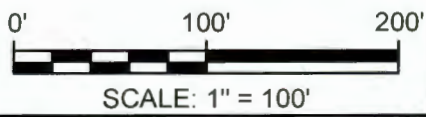

Map Source: Jefferson County
Tax Lot Map 13.09.16DB, 03300
Ground Controls By:
Fred A. Ast, Jr. - PLS

CASCADE
GEOENGINEERING
360.907.4162
cascadegeoengineering.com

COBU Map T-11645
Hank Barton
Camp Sherman, Jefferson County, Oregon

DESIGNED BY: J. Newton	DRAWN BY: R2D	DATE: OCT 2018	PROJECT NO. 1015-101	FIGURE 2
---------------------------	------------------	-------------------	-------------------------	-------------