


CLAIM OF BENEFICIAL USE MAP FOR T-12325

T 38 S, R 8 W, W M, JOSEPHINE COUNTY

Section 22, SE1/4 NW1/4

October 26, 2017

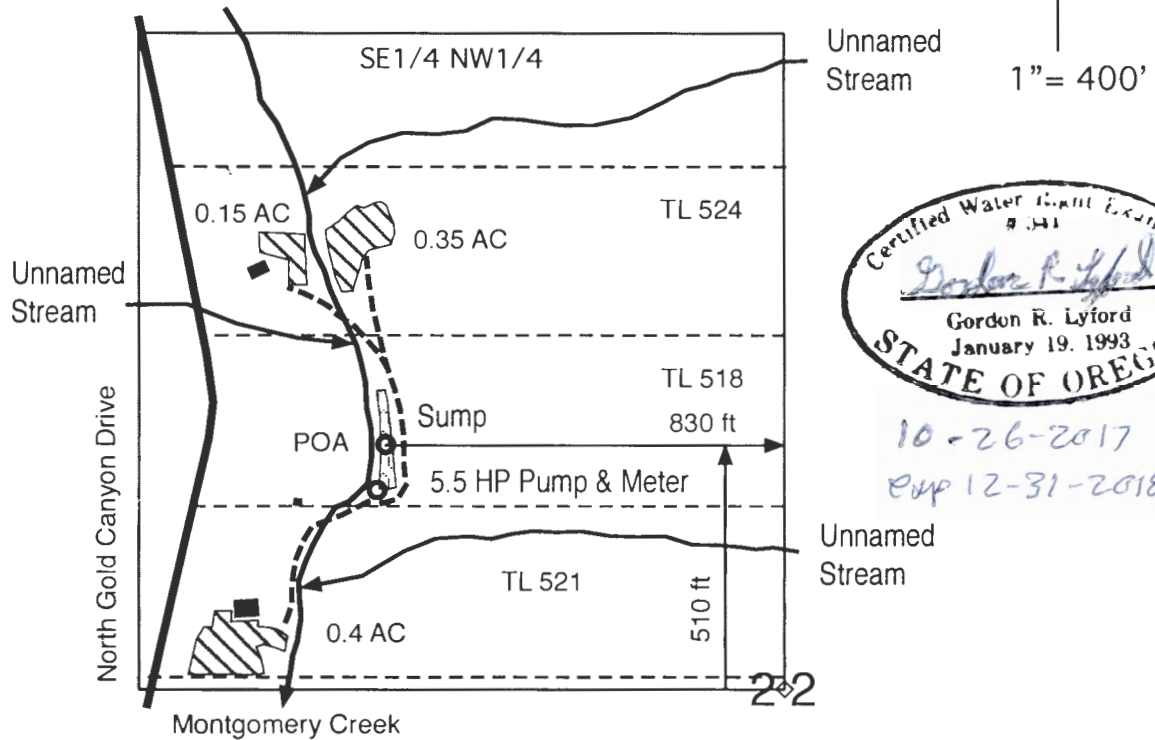

○ Point of appropriation (POA) from the one sump.

▨ 0.9 acres of irrigation rights from one sump under application G-6696 and permit G-6242 with a priority of October 18, 1974 at a rate of 0.0125 cfs/acre and a duty of 2.5 AF/AC.

--- Above ground distribution poly hoses with 1.5", 1.25", and 1" diameters.

--- Tax lot lines.

■ Houses.

RECEIVED BY OWRD

OCT 30 2017

SALEM, OR

This map was drawn by Gordon R. Lyford for Dawn R. Present to support her claim of beneficial use of water from one sump under T-12325 for irrigation at new places of use. Dawn R. Present owns tax lots 518, 521, and 524.

This map was prepared for the purpose of identifying the location of water rights only and is not intended to provide legal dimensions or the location of property ownership lines.