

RECEIVED BY OWRD

OCT 27 2014

SALEM, OR



RECEIVED

OCT 2

SALEM, OR

CLAIM OF BENEFICIAL USE  
TRANSFER T-6585  
SE1/4, SECTION 9, T.33S., R.2E., W.M.  
JACKSON COUNTY, OREGON  
FOR  
S AND S UNLIMITED, INC.  
MR. JAMES BLANKENSHIP, PRESIDENT  
P.O. BOX 664  
SHADY COVE, OR 97539

1/4 Corner  
Found J.C.S.  
Brass Cap

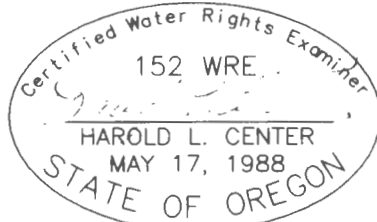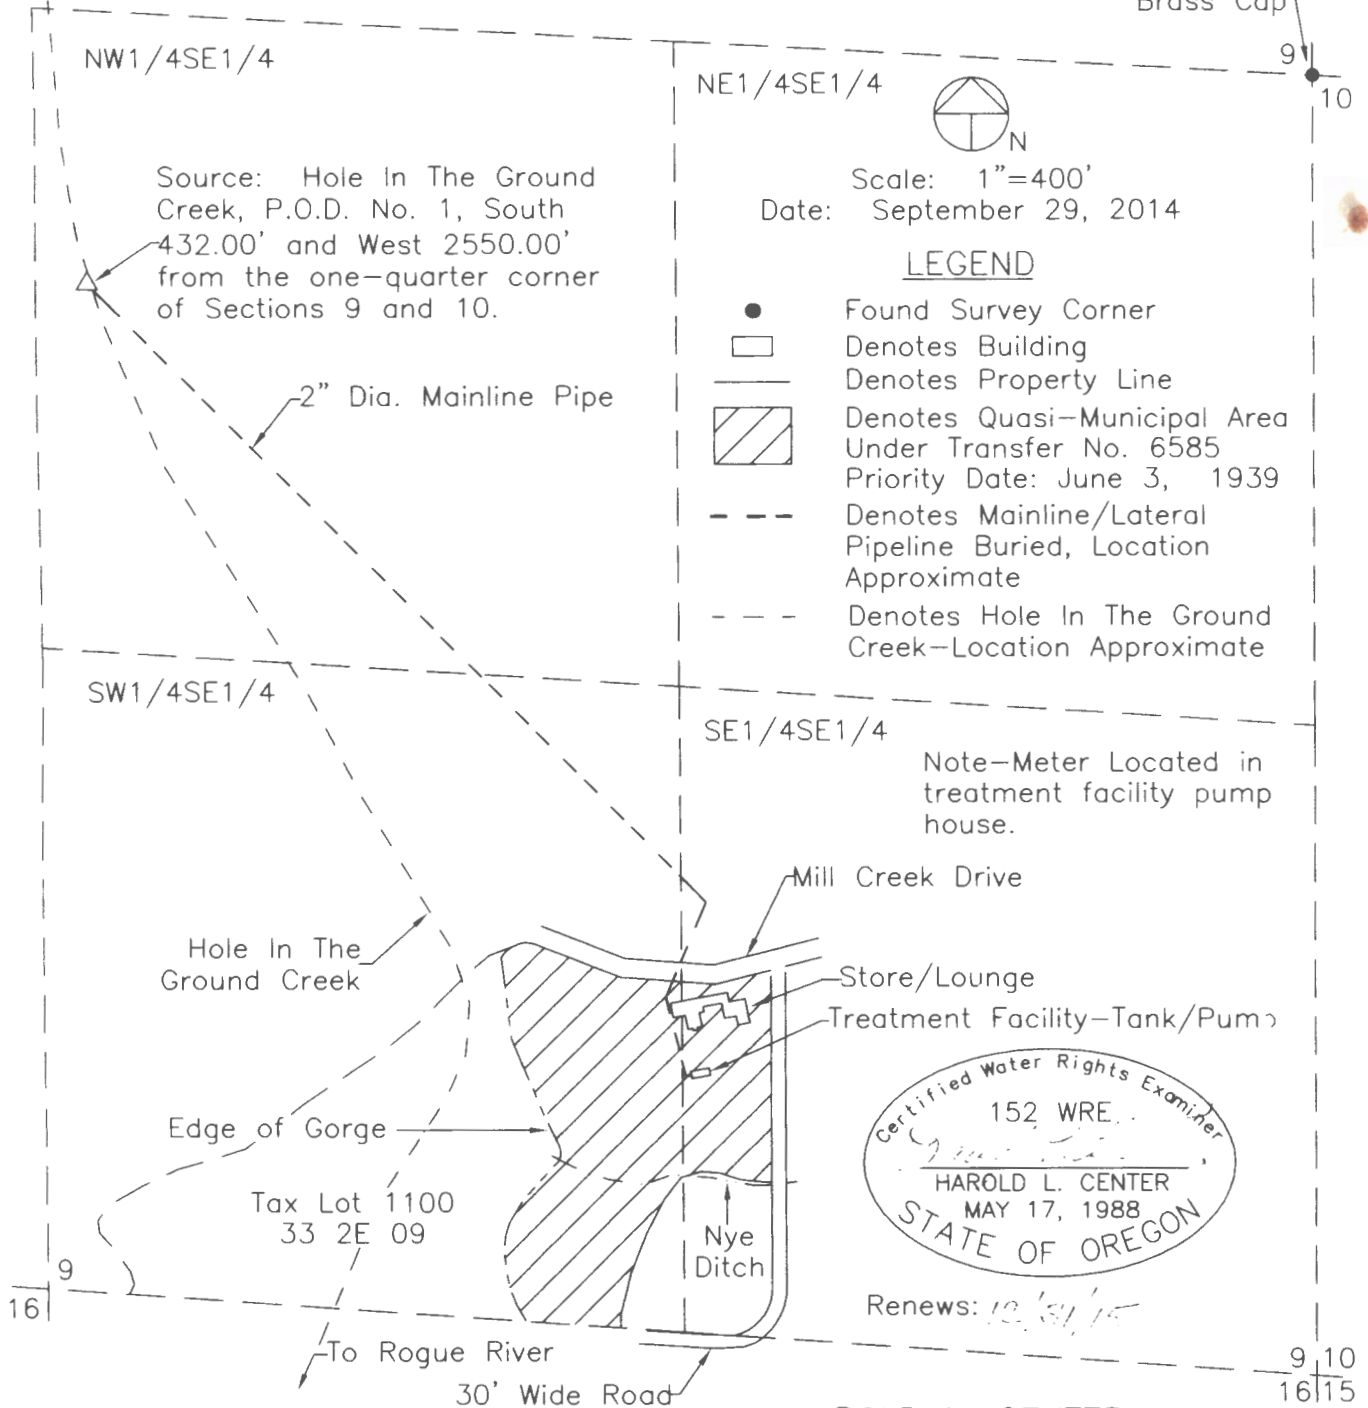

This map was prepared for the purpose of identifying the location of a water right only and is not intended to provide legal dimensions or location of property ownership.

HAROLD L. CENTER  
2604 David Lane  
Medford, OR. 97504  
Phone 541-535-6108  
Oregon Certificate No. 152