

This map is not intended to provide legal dimensions or locations of property ownership lines.

T12S R4W, W.M.

Final Proof Survey  
**Transfer T-13168**

Certificate 80359

In the name of

**Bannockburn Farms, Inc.**

To: 

Prepared by  
 Walter L. Trimmer  
 CWRE #332  
 Trimmer Engineering  
 2484 NW Maser Drive  
 Corvallis, OR 97330  
 541-754-2819

RECEIVED

SEP 23 2021


OWRD

Scale 1" = 1320'

September 3, 2021  
 Layout: Macpherson  
 File: MuddyCrks.dwg  
 Based on USGS Peoria Quad  
**DWG 1 of 1**



PLS Boundary - - - - -  
 Lot Lines - - - - -  
 QQ Lines - - - - -

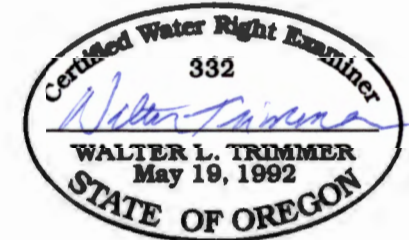

Expires 6/30/2022