


8458

9711
72401

Sec. 18 T. 38 S. R. 15 E. W. 17. creek
Sec. Cor. 1/2 Cor. 11

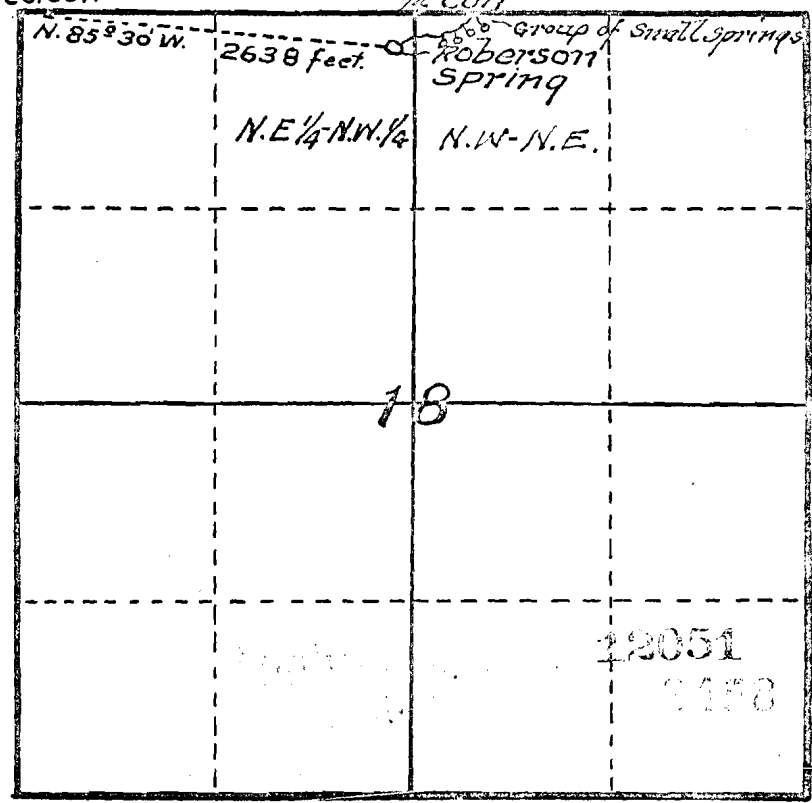

Charles A. Nutter
Registered Dec. 31 1919 No. 863 Civil Engr.

Fish Hole Cr. : Mac