


# T.4S. R.1E. Section 16, W.M.

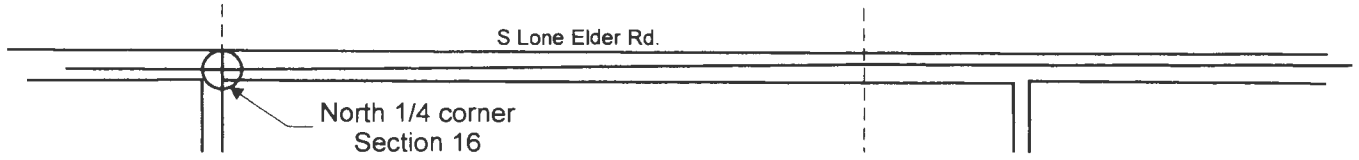

Well 2 is located 1,850 feet south and 1,445 feet east from the N1/4 corner, Section 16.


 Area (9.84 Acres) authorized under Certificate 58345, priority date June 14, 1977.

----- Tax lot boundary      ..... Water main line


RECEIVED

MAY 27 2021

OWRD

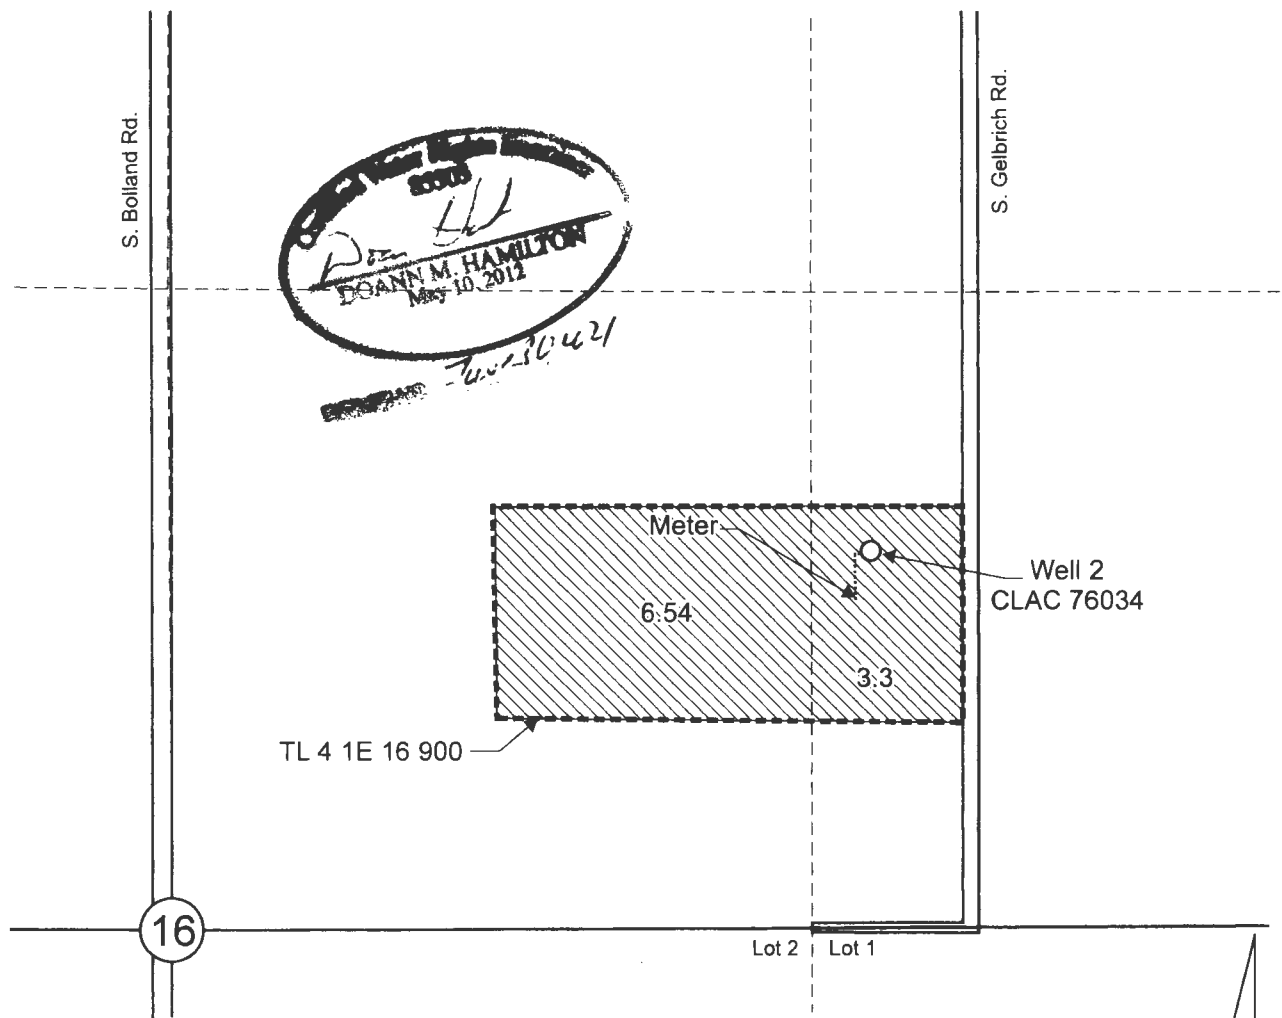

Scale: 1" = 400'

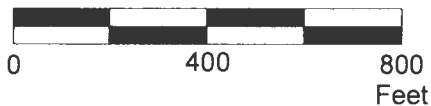

This map was prepared for the purpose of identifying the location of a water right only and is not intended to provide legal dimensions or location of property ownership lines.

Claim of Beneficial Use Map  
T-12333

Agile Development, LLC  
T.4S. R.1E. Section 16, W.M.

Pacific Hydro-Geology Inc.

05/2021