


**T26S R33E, WM,
HARNEY COUNTY, OR**

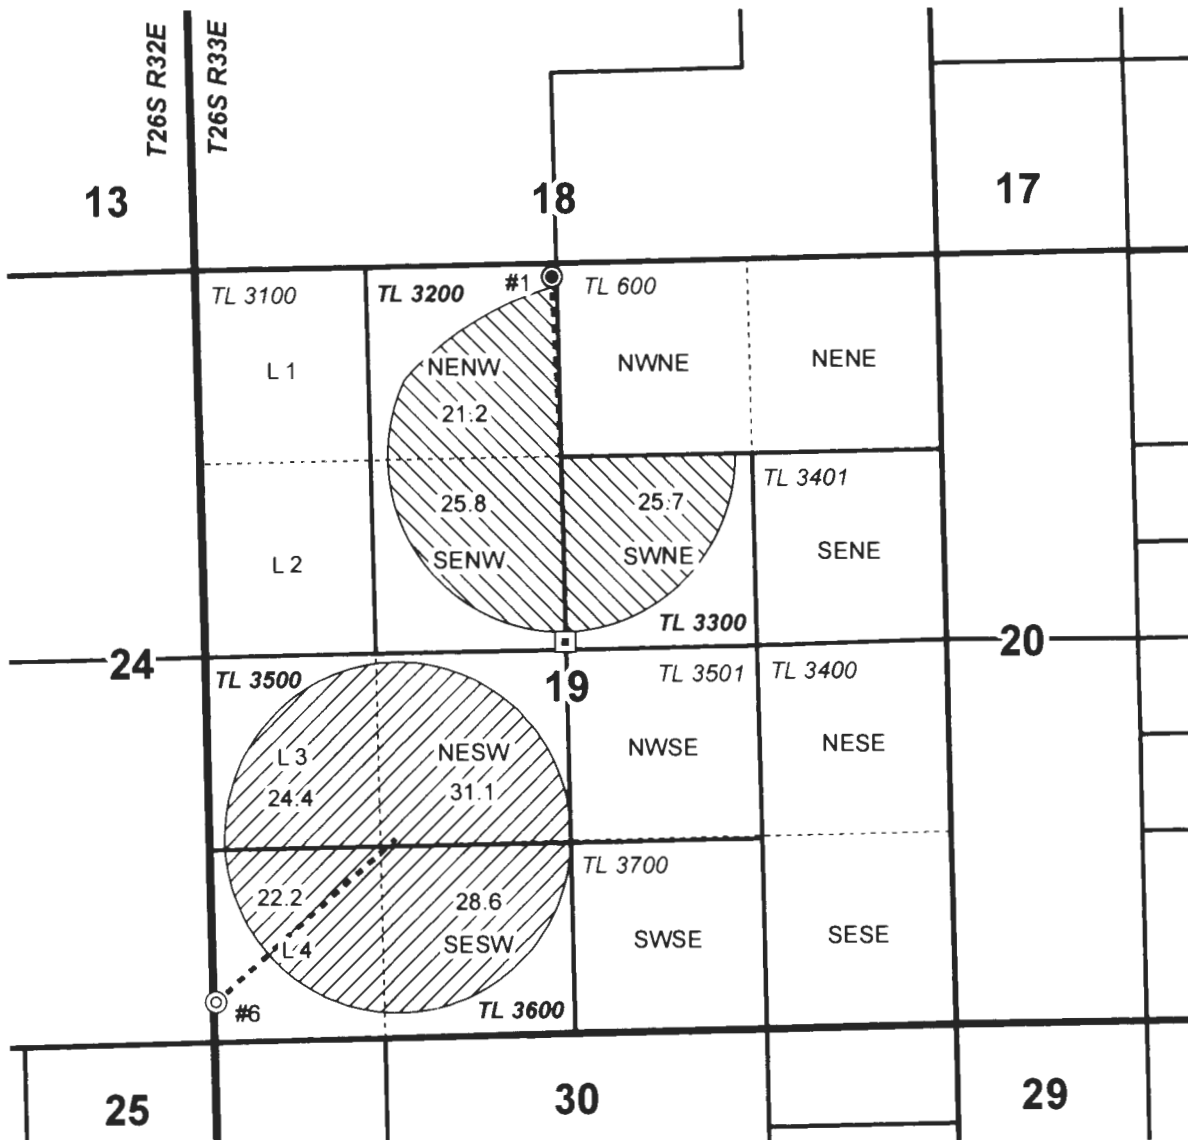


0 1,320 Feet

1" = 1320'



- Well
- ⊙ Well & Meter
- Meter for Well #1
- Pipeline
- POU IR (Priority 5-19-1981, from C-82608)
- POU IR (Priority 4-7-1981, from C-91751)
- Township
- Section
- Quarter Quarter
- Tax Lot

Well Locations:
 Well #1 (HARN 1391): 90' S, 30' W of N 1/4 Cor Sec 19
 Well #6 (HARN 1392/L-102509): 280' N, 10' E of SW Cor Sec 19

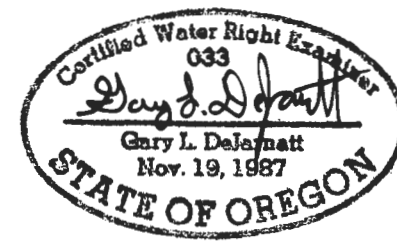

RENEWAL DATE 12/31/2021



**CLAIM OF BENEFICIAL USE MAP
NICHOLS RANCH**

T-12377 (Transfer of C-82608 & C-91751) Project #20034 Date: 6/19/2020

This map is not intended to provide legal dimensions or locations of property ownership lines.

WATER RIGHT SERVICES, LLC
 PO BOX 1830, BEND, OR 97709
 WWW.OREGONWATER.US CCB # 197121
 johnshort@usa.com 541-389-2837