

ATTACHMENT 1
Claim of Beneficial Use Map
 Permit R-14272
 T1S R4E Sec 29

RECEIVED
 MAY 15 2002
 STATE




- Reservoir
- Mainline
- Groundwater Well
- Un-named Stream
- Taxlot 0900
- taxlots
- Quarter-quarter
- Section

Water Rights Examiner
 #1101
RL2
 Robert E. Long Jr
 May 15, 2002
 STATE OF OREGON
 EXPIRATION DATE: ~~12-31-2002~~

T1S R4E S29
 T1S R4E S28
 T1S R4E S32
 T1S R4E S33
 NENE
 NWNW

CWM-H2O
 Complete Water Management
 1319 SE MLK, Jr. Blvd, Suite 204
 Portland, Oregon 97214
 (503) 954-1326

This map is not intended to provide legal dimensions or locations of property ownership lines

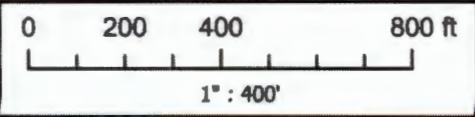

No.	Date	By	Revisions
1	DATE	AUTH	DRAFT
1	09/24/20	IAG	DRAFT

Proj#: 1612001
 S. Williams CBU
 Steve Williams
 9664 SE Revenue Rd
 Boring, OR, 97009

