

RECEIVED


SEP 19 1994

WATER RESOURCES DEPT.  
SALEM, OREGON

T. 5 N., R. 28 E., W.M.



SCALE 1" = 1320'

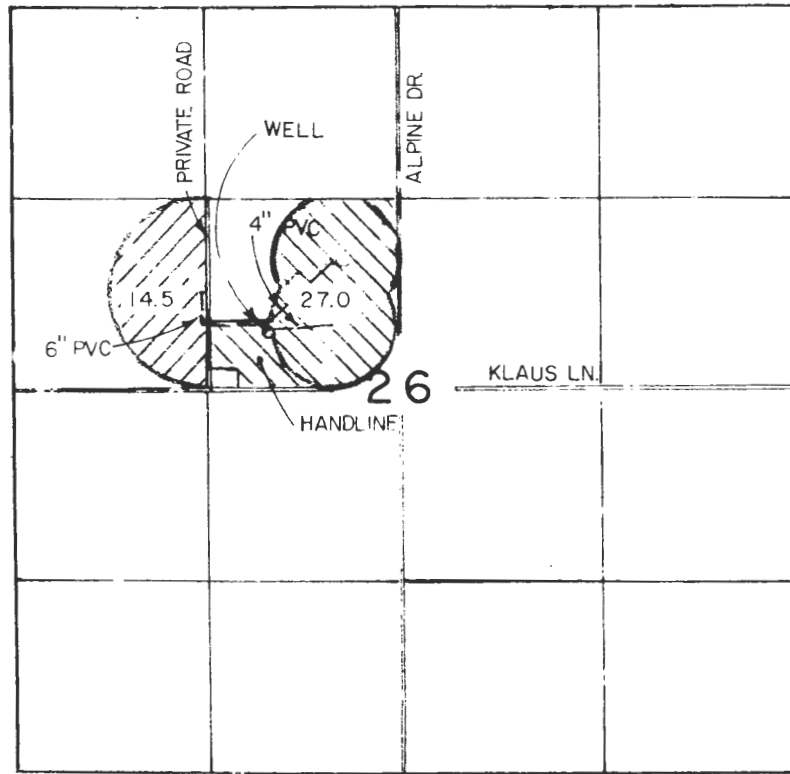

WELL LOCATED 400' N & 1750' E FROM W 1/4 CORNER.

# FINAL PROOF SURVEY

UNDER

Application No. G-12076

Permit No. G-11406

IN NAME OF

W. BRYAN & LOU ANN WOLFE  
and  
ROBERT & DOROTHY GREENWOOD

THIS MAP IS FOR THE PURPOSE  
OF IDENTIFYING THE LOCATION  
OF WATER RIGHTS ONLY AND IS  
NOT INTENDED TO PROVIDE  
LEGAL DIMENSIONS OR LOCATIONS  
OF PROPERTY OWNERSHIP LINES.

