


# MAP

To Accompany Application of  
School District No 25, Coos Co. Ore.


for a permit

To appropriate water in Sec 24  
T. 27 S. R. 12. W. W. M. Coos Co Ore.

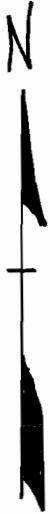

Scale

Two inches = one mile

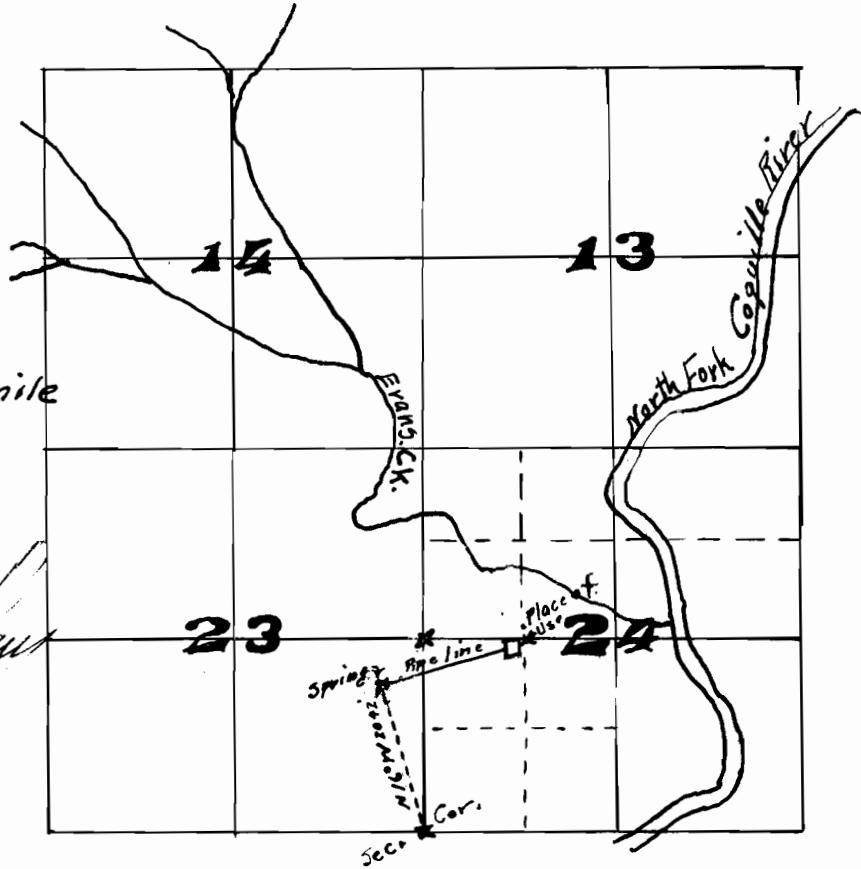

*D. L. Buckingham*  
1927

I, **D. L. Buckingham** of Marshfield, Oregon  
do hereby certify that this map was made from notes  
taken during an actual survey made under my direction  
July 25, 1927 and that it correctly represents the  
works described in the accompanying application  
together with the streams in the immediate vicinity

*D. L. Buckingham*

Application No. 12910

Permit No. 2004