





T.3S. R.3W. Section 34 and T.4S. R.3W. Section 3, W.M.

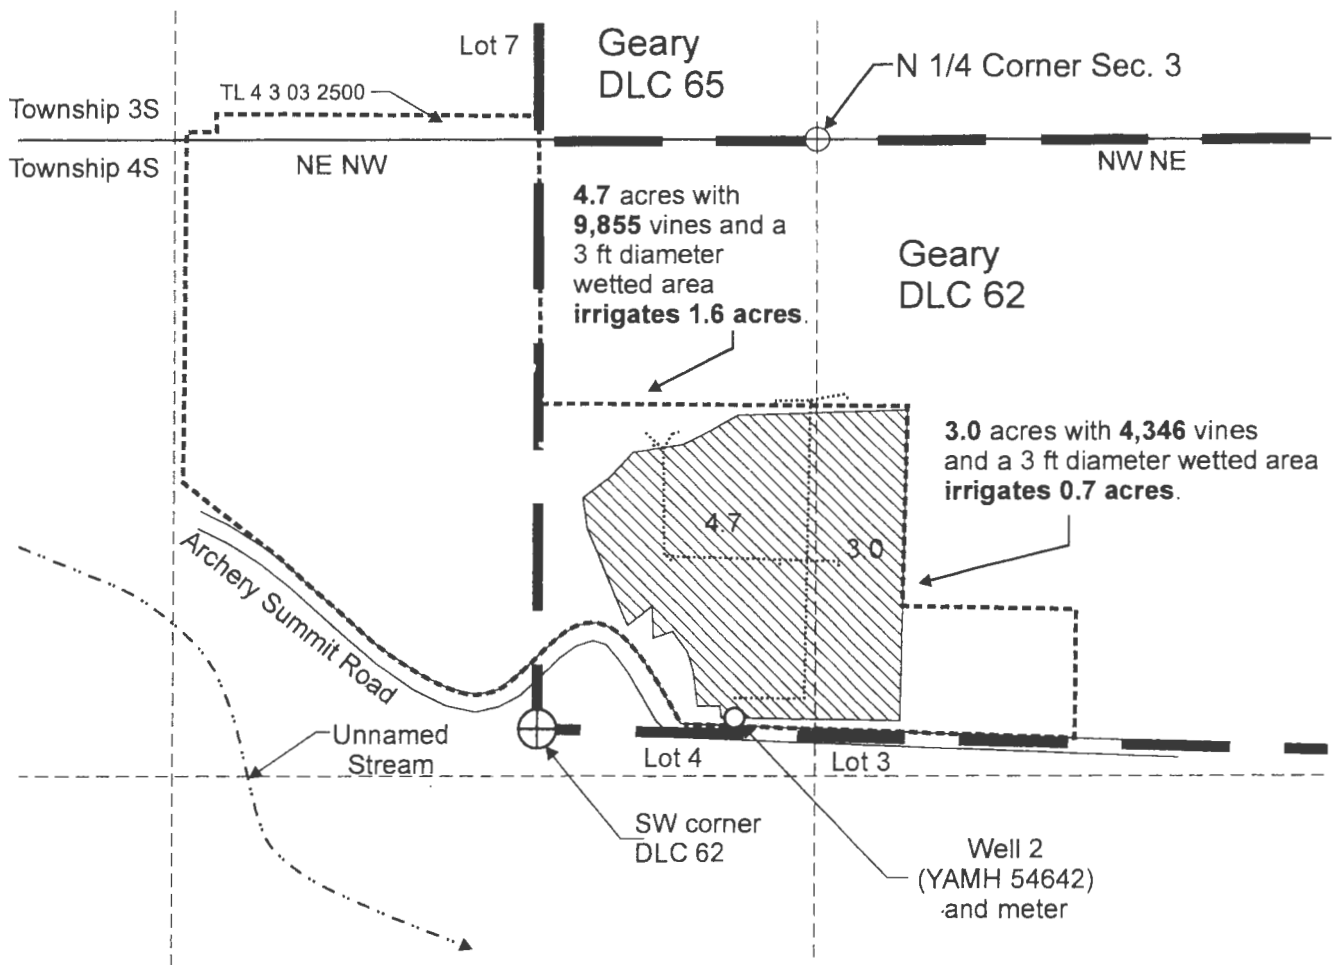

Well 2 (YAMH 54642) is located 20 feet north and 405 feet east from the SW corner, DLC 62.

 Area (2.3 acres) irrigated under Application G-16914, Permit G-17811, T-12431.

-  Tax lot boundary
-  Donation Land Claim boundary
-  Mainlines

RECEIVED

DEC 13 2022

OWRD



JUN 30 2021

Scale: 1" = 400'



This map was prepared for the purpose of identifying the location of a water right only and is not intended to provide legal dimensions or location of property ownership lines.



Claim of Beneficial Use Map
Application G-16914, Permit G-17811, T-12431

Archery Summit Winery
T.3S R.3W. Section 34 and
T.4S. R.3W. Section 3, W.M.

Pacific Hydro-Geology Inc.

04/2021