


T.3S. R.1E. Sec. 23 & 26, W.M.

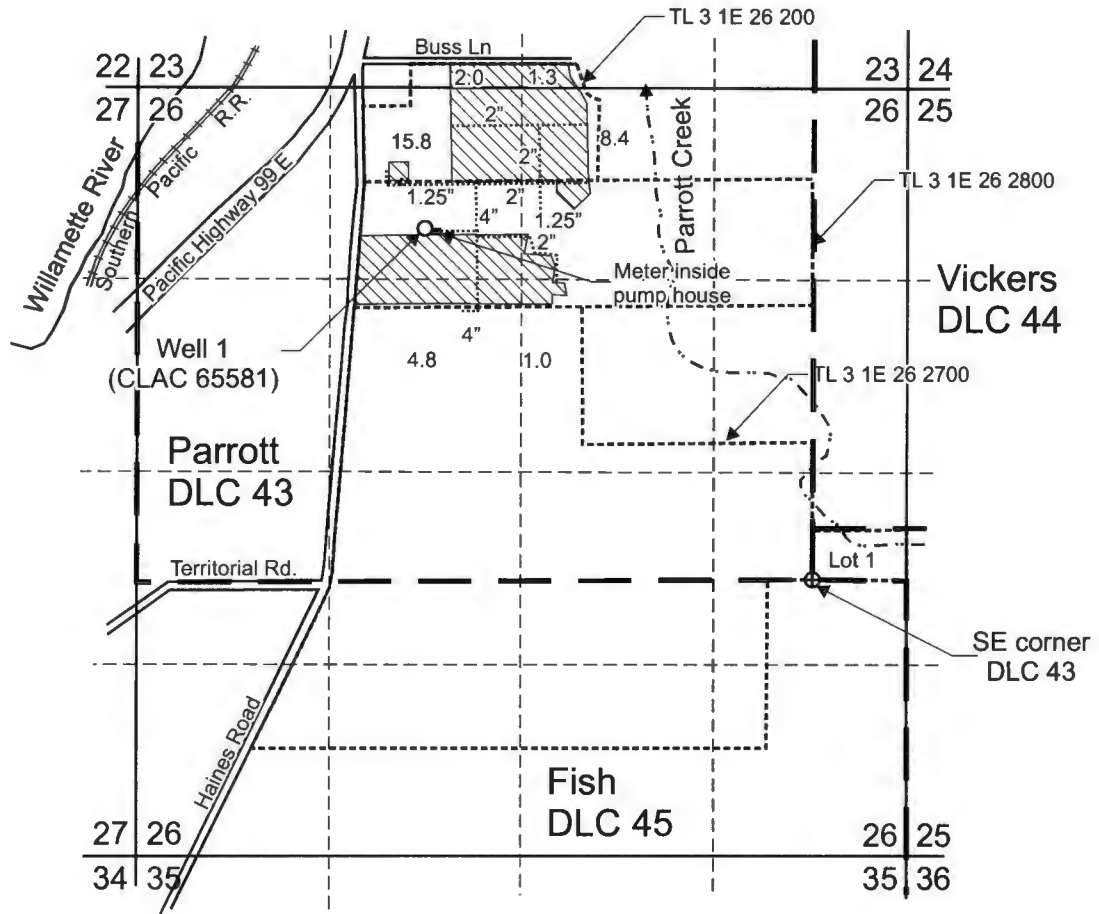

RECEIVED
 MAR 04 2020
 OWRD

Well 1 (CLAC 65581) is located 2,410 feet north and 2,650 feet west from the SE Corner, DLC 43.

Area (33.3 Acres) of nursery operations under Application G-17158, Permit G-16544.

Tax Lot boundary

Donation Land Claim boundary

Water main line



June 30, 2021

Scale: 1" = 1,320'



This map was prepared for the purpose of identifying the location of a water right only and is not intended to provide legal dimensions or location of property ownership lines.



Claim of Beneficial Use Map
Application G-17158, Permit G-16544

Pacific Hydro-Geology Inc.

Birkemeier Farms Inc.
 T.3S. R.1W. Sec. 23 and 26, W.M.

02/2020