

**T24S R32E, WM,
HARNEY COUNTY, OR**



0 400 Feet

1" = 400'

● Well & Meter

 POU IR

 Section

 Quarter Quarter

 Tax Lot


Well Locations:

**Well #1 (HARN 921/52140):
820' S, 680' E of W 1/4 Cor Sec 12**


RECEIVED

DEC 9 2022

OWRD

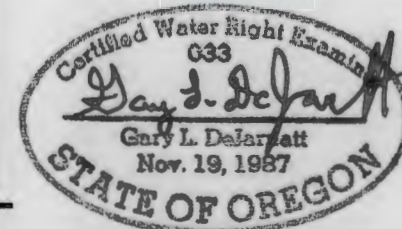

RENEWAL DATE 12/31/2023

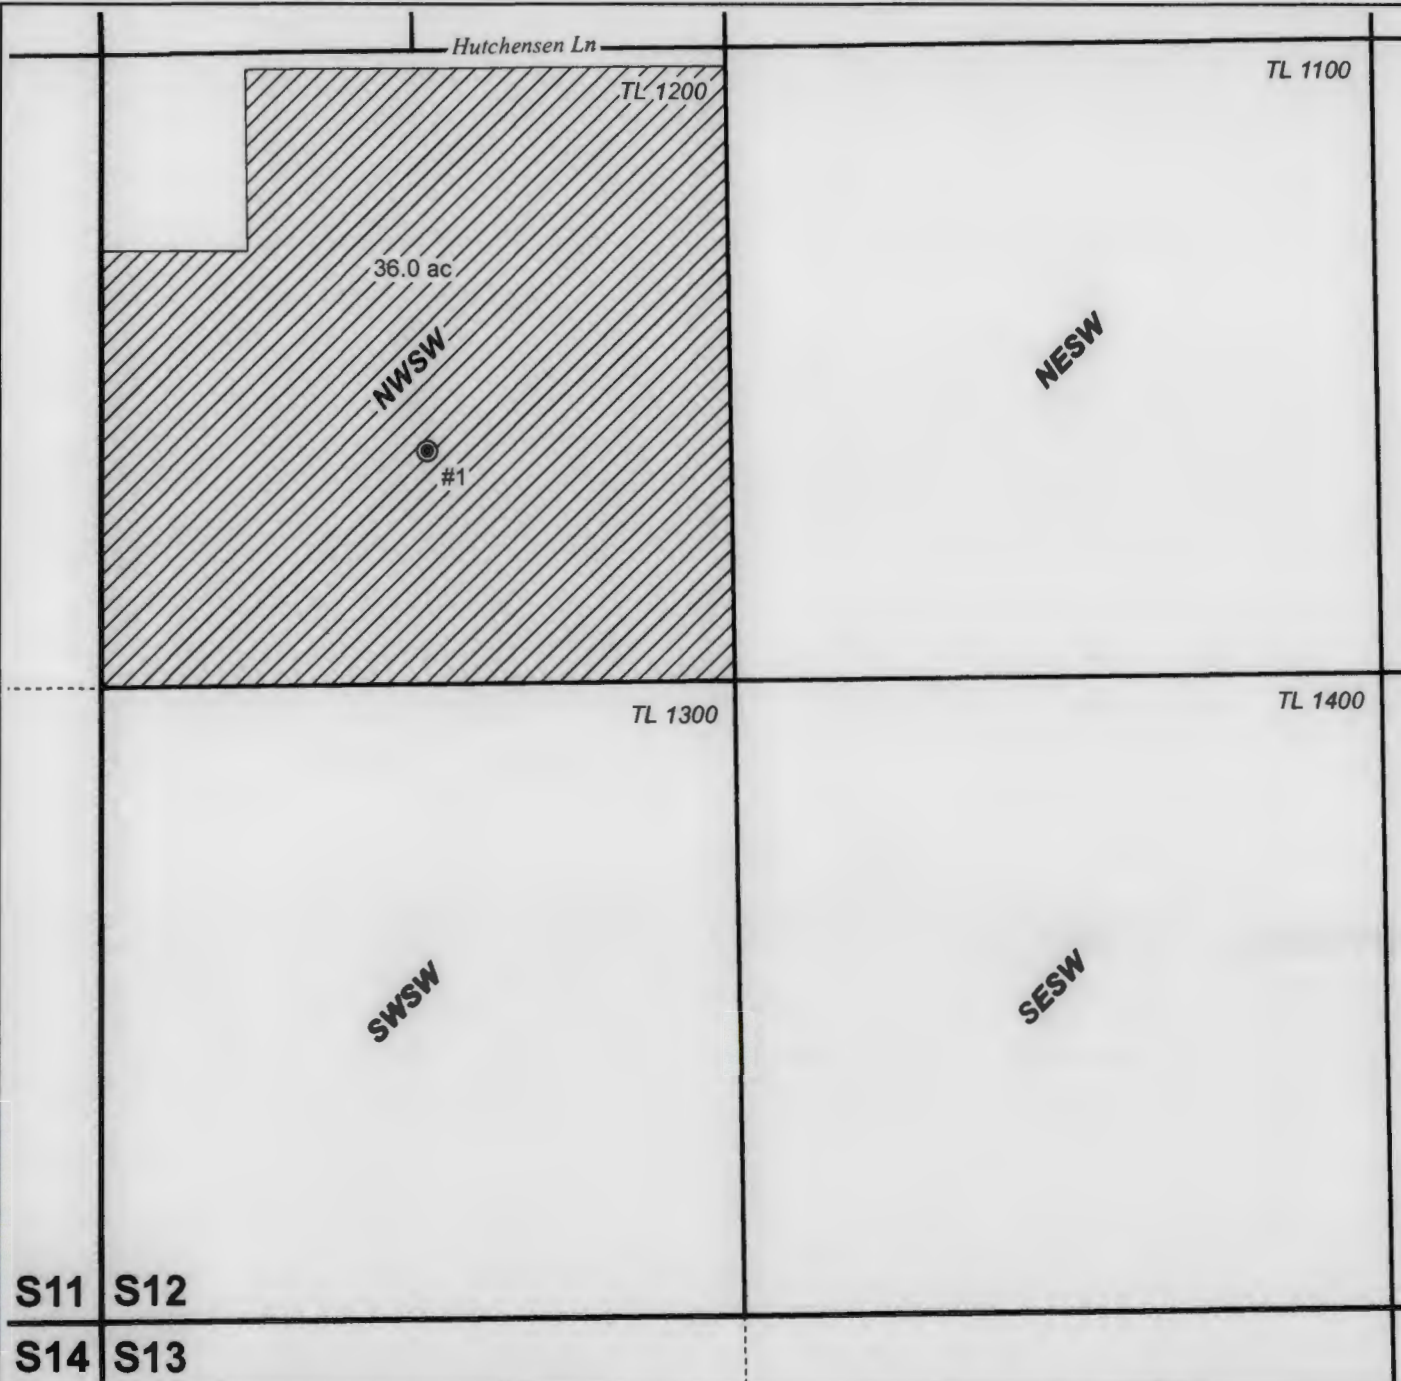

S11 S12

S14 S13

**CLAIM OF BENEFICIAL USE MAP
Rocky Mountain Agronomics, Inc.**

Ap G-17490 Permit G-17794

Project #22053

Date: 10/27/2022

This map is not intended
to provide legal dimensions
or locations of property
ownership lines.

WATER RIGHT SERVICES, LLC
PO BOX 1830, BEND, OR 97709
WWW.OREGONWATER.US CCB # 197121
johnshort@usa.com 541-389-2837