


**T15S R10E, WM
DESCHUTES COUNTY, OR**



- Well & Meter
- Pipeline
-  Storage for FI, WI, FP, & RC Uses
-  Pond Maintenance
-  Section
-  Tax Lot
- Quarter Quarter

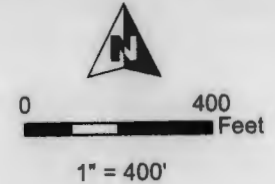


RENEWAL DATE 12/31/2023

RECEIVED

DEC 9 2022

OWRD

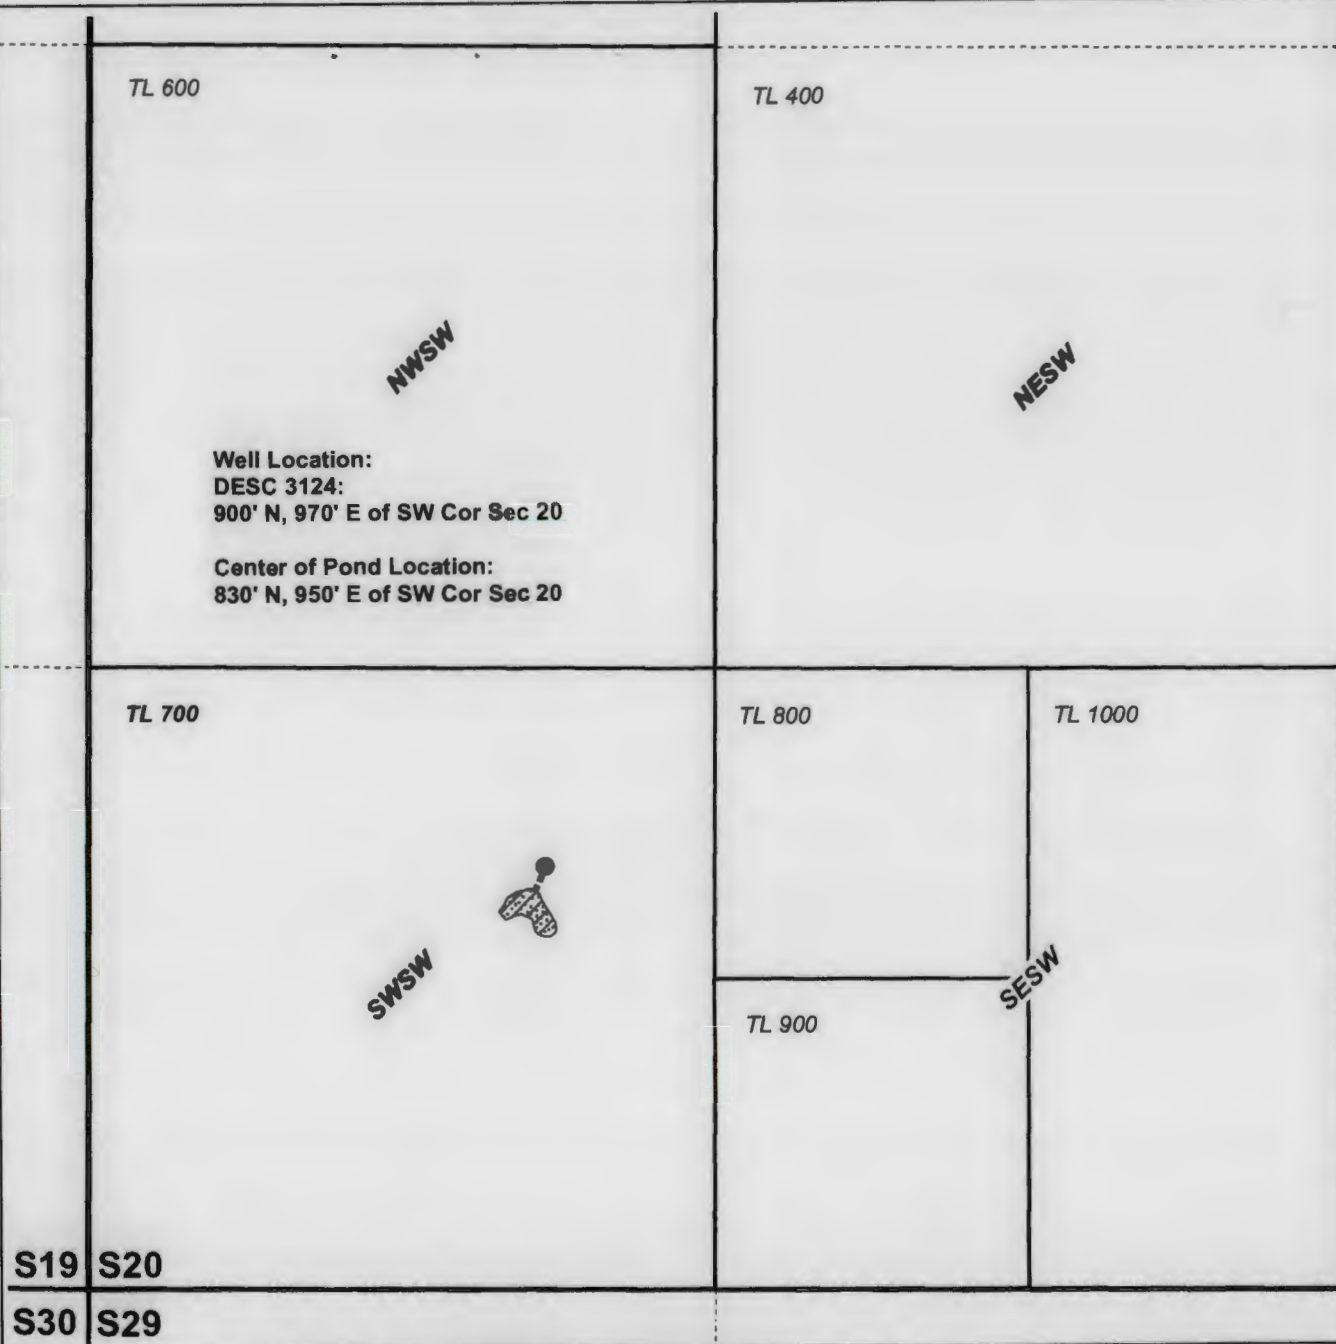

CLAIM OF BENEFICIAL USE MAP
Klassen

This map is not intended
to provide legal dimensions
or locations of property

WATER RIGHT SERVICES, LLC
PO BOX 1830, BEND, OR 97709
WWW.OREGONWATER.US CCB # 197121