

1600

1700

See Map

12

33 S. 3 E.

10

PARKER MEADOWS RD.
RIVER
1800

2400

2300

1900

EXHIBIT A, HE 238
CERTIFICATE # 76673
Map 1 of 2

ROGUE

2200

FORK
2500

15

14

13

91-2

BUCK

3400

CREEK

3500

3900

HE 238

ROAD

22

23

24

3602

0.20
Ac

3600

3600

3069Ac

3501

6.60
Ac

3700

40.00 Ac

3601

0.08
Ac

4300

4200

4200

499.07Ac

4100

131.73Ac

EFU
(P-10445)

4101

15.00
Ac

26

25

27

BUTTE FALLS

5200

5400

5400

5500

LÖG
POND

34

35

36

5300 PROSPECT

MEDCO

LOGGING

RECEIVED

DEC - 9 1997

WATER RESOURCES DEPT.
SALEM, OREGON

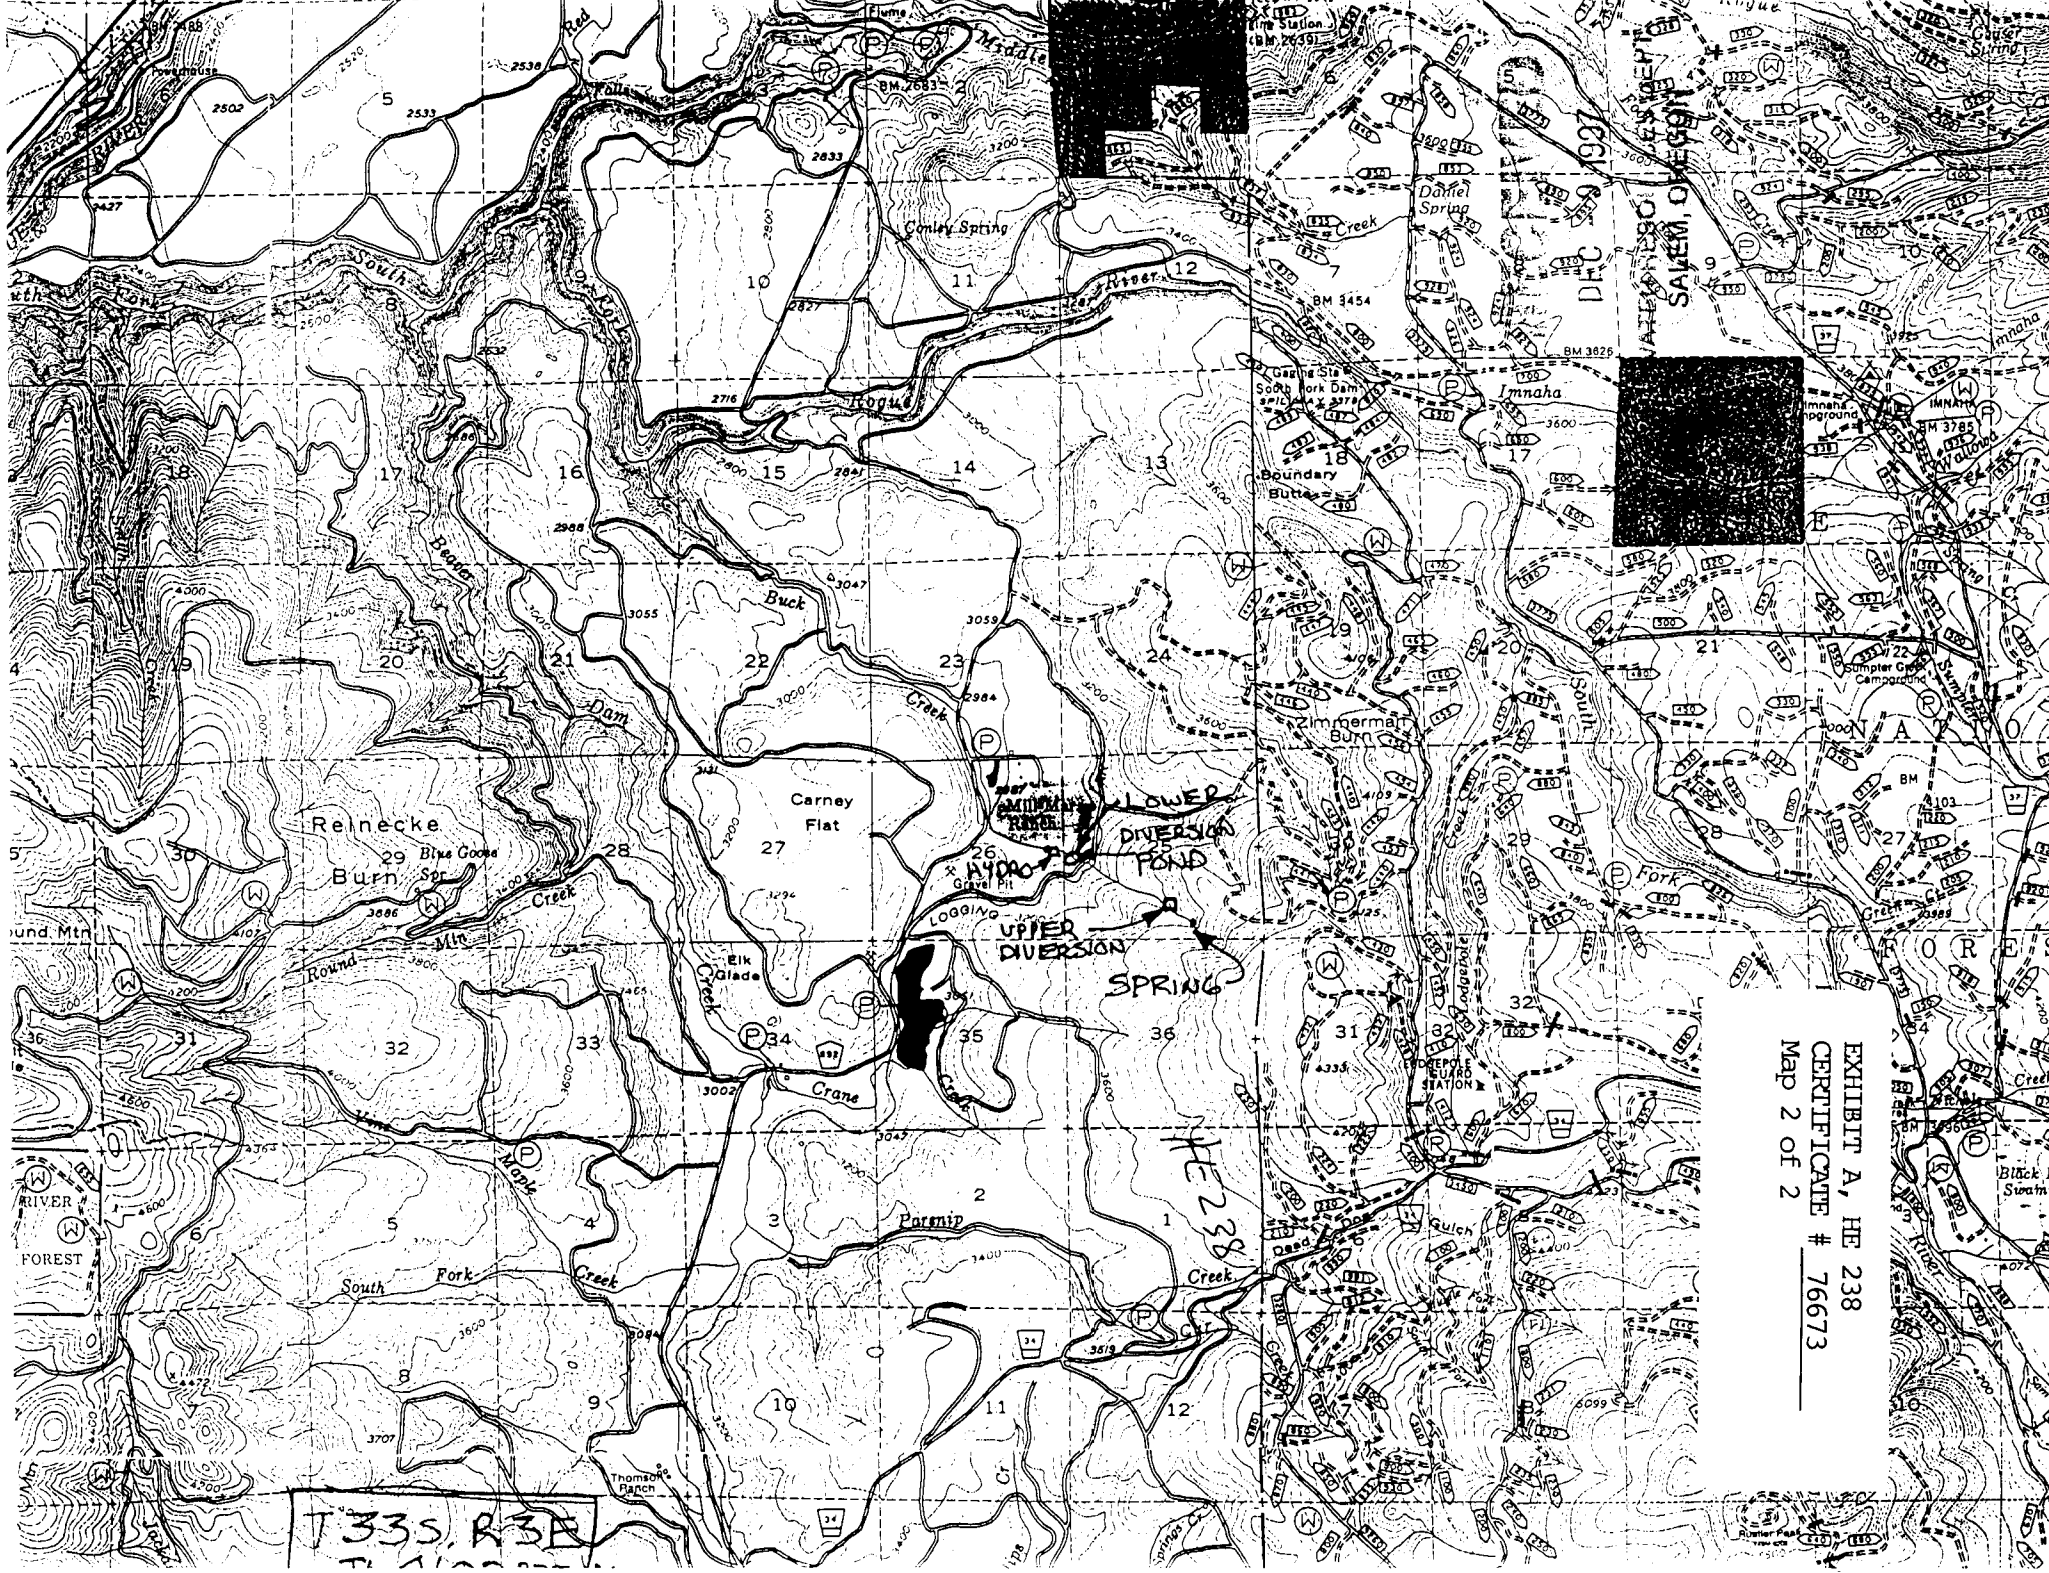


EXHIBIT A, HE 238
CERTIFICATE # 76673
Map 2 of 2

T 33 S. R 3 E

LOWER DIVERSION POND
UPPER DIVERSION POND
SPRING

REINECKE BURN SER