

RECEIVED

AUG 30 2021


OWRD

T.6S. R.2W. Sec. 8 & 9, W.M.


Well (MARI 4175) is located 860 feet north and 485 east from the SW corner, Section 9.

 Area (16.6 Acres) irrigated under T-12961 formerly Certificate 30812, priority date 8-1-58.

 Tax lot boundary  Donation Land Claim boundary  Water main line

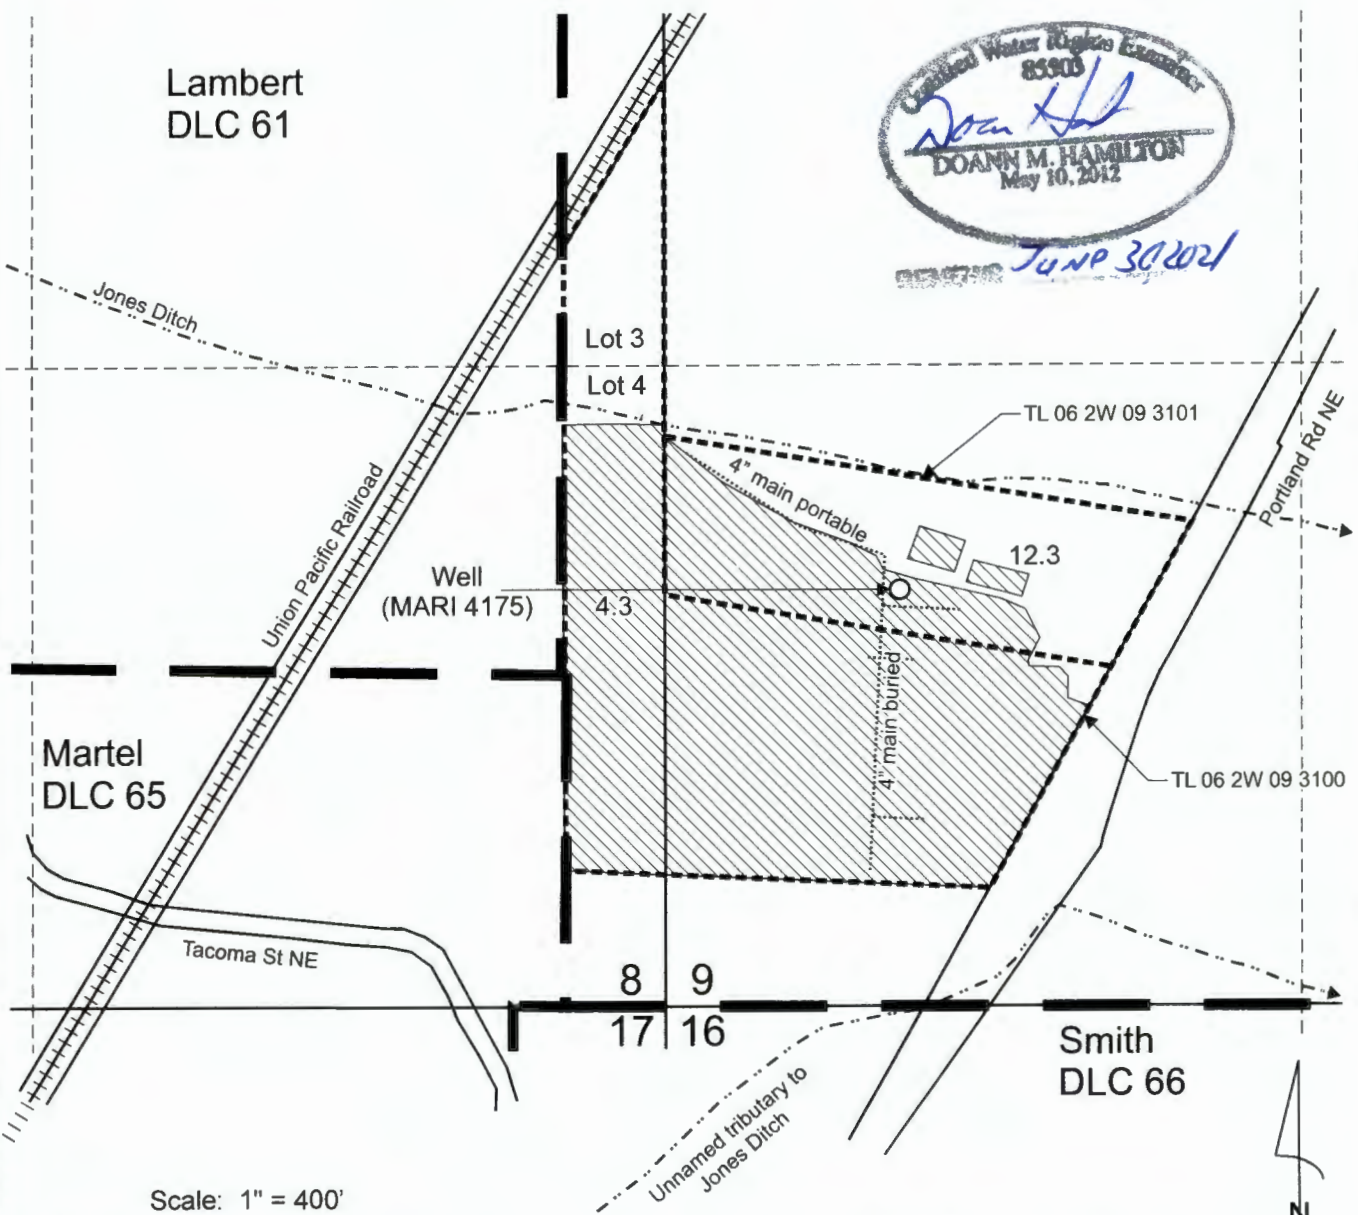

Scale: 1" = 400'

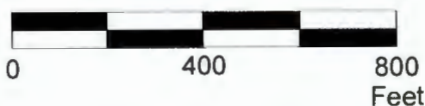

This map was prepared for the purpose of identifying the location of a water right only and is not intended to provide legal dimensions or location of property ownership lines.

Claim of Beneficial Use Map
T-12961 formerly Certificate 30812

David G. And Kathryn S. LeCompte
T.6S. R.2W. Sec. 8 & 9, W.M.

Pacific Hydro-Geology Inc.

03/2021

Brooks Tree HPT-12961 COBU Map.cdr