


# Claim of Beneficial Use Map Transfer T-12927

T 36 S, R 3 W, WM  
Section 33

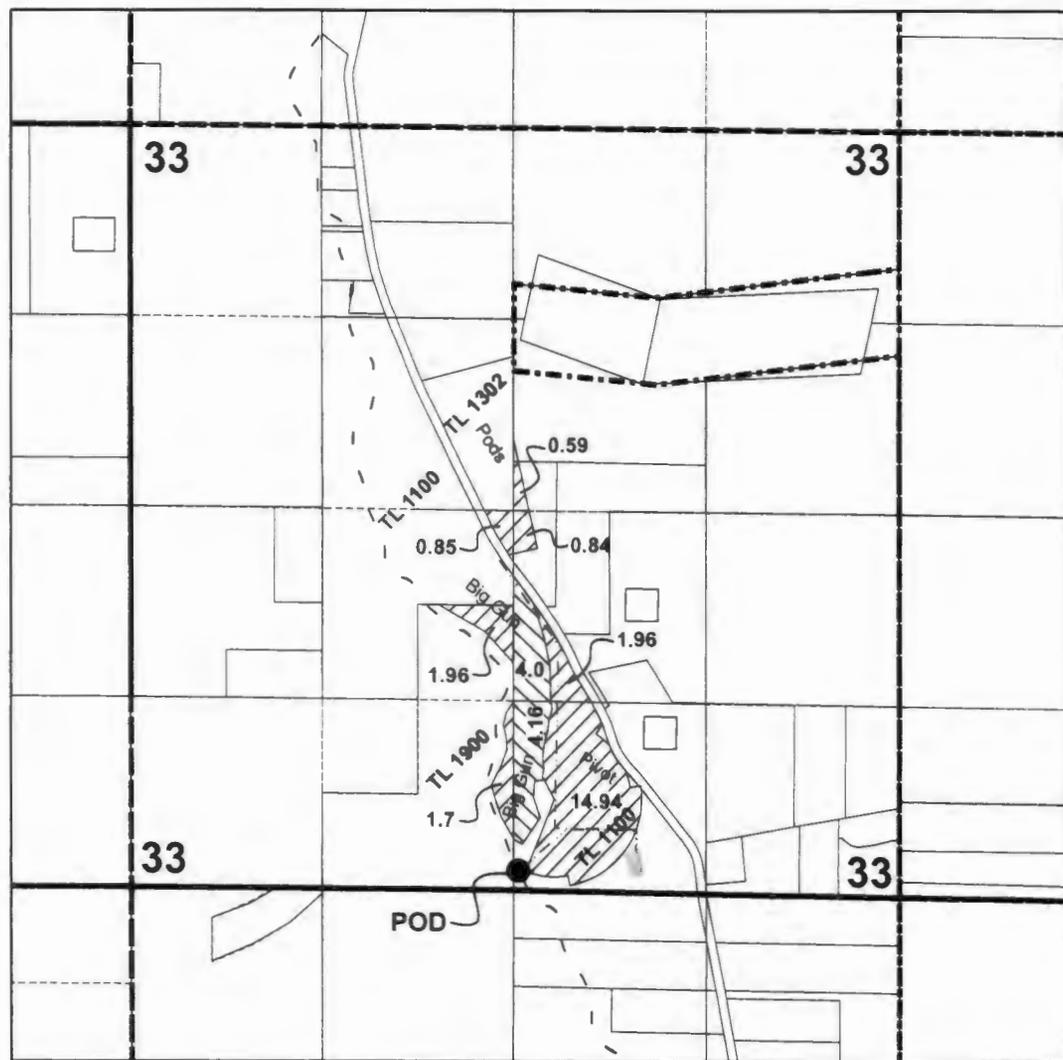

### Legend

-  Area irrigated 22.84 ac POD & POU
-  Area irrigated 8.16 ac POD only
-  Bulge pond
-  6" Mainline PVC pipe


Point of Diversion located  
 In the SW1/4, SE1/4 of  
 Section 33, T36S, R3W, WM  
 North 134 ft & East 14 ft From  
 South 1/4 Cor of Sec 33  
 T 36 S, R 3 W, WM

Note: This map shows the  
 area irrigated by T-12927  
 only. There are other water  
 rights filling out the area  
 irrigated.

Note: the Bulge Pond is used  
 to accumulate low flow from  
 creek so irrigation system can  
 be used in surges.



1 inch = 1,320 feet

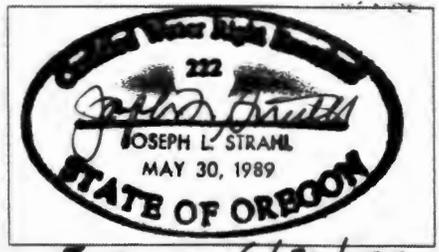

*Expires 6/30/22*

Note: This map is not intended  
 to provide legal dimensions or  
 locations of property ownership  
 lines.