


CLAIM OF BENEFICIAL USE MAP

TO CHANGE PLACE OF USE AND
CHANGE POINT OF APPROPRIATION PER

APP T-12468
GILLETTE LIVING TRUST

SECTION 17, TOWNSHIP 27 SOUTH, RANGE 18 EAST, W.M.
TAX LOT: 1900 & 2400 LAKE COUNTY, OREGON

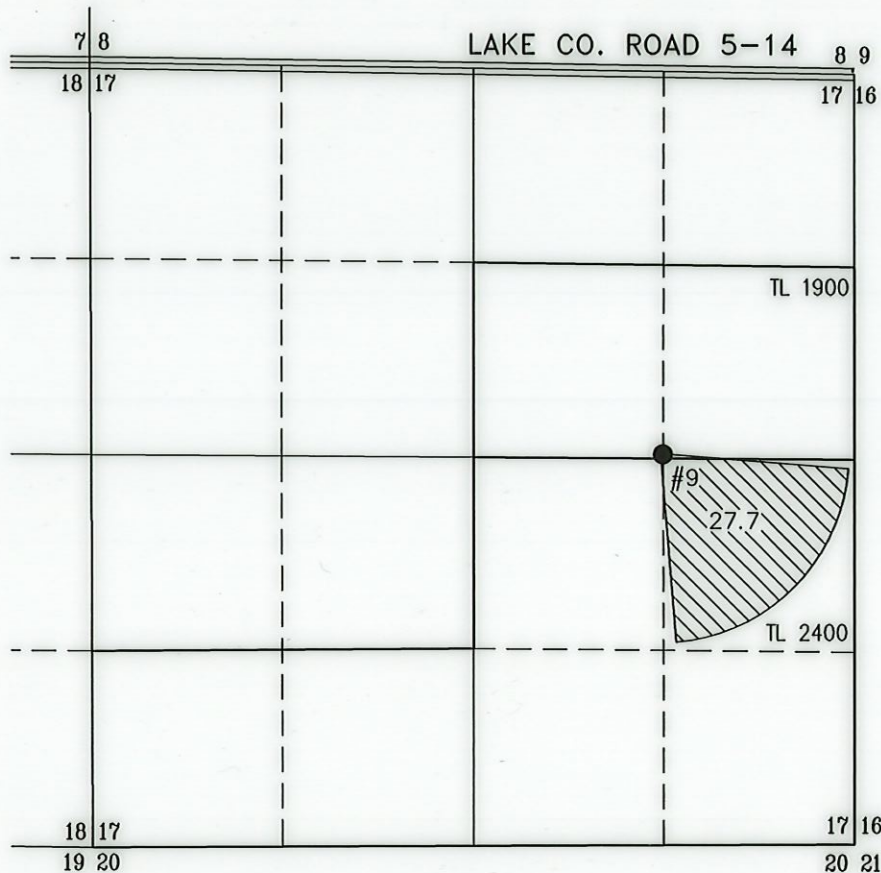

- #9
TRANSFER WELL (LAKE 52360)
0' SOUTH & 1320' WEST FROM THE E 1/4 CORNER
SECTION 17. FLOWMETER LOCATED 12 FEET WEST
FROM WELL.




27.7 ACRES 'IR' FROM POA 9
& C#54692, AS SHOWN

RECEIVED

JUN 20 2023

OWRD

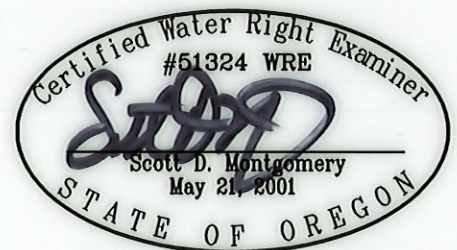

RENEWAL DATE: 12/31/2024

THIS MAP IS FOR THE PURPOSE OF LOCATING A WATER
RIGHT ONLY AND HAS NO INTENT TO PROVIDE LEGAL
DIMENSIONS OR THE LOCATION OF PROPERTY LINES

PREPARED FOR:

SANDRA OVERTON
P.O. BOX 556
CHRISTMAS VALLEY, OR 97641

PREPARED BY:



ALL POINTS ENGINEERING AND SURVEYING, INC.
P.O. BOX 767
(541) 548-5833
TERREBONNE, OR 97760
www.APEandS.com