



CLAIM OF BENEFICIAL USE MAP

TO CHANGE PLACE OF USE AND
CHANGE POINT OF APPROPRIATION PER

APP T-12468
GILLETTE LIVING TRUST


SECTION 18, TOWNSHIP 27 SOUTH, RANGE 18 EAST, W.M.
TAX LOTS: 2801 & 3801 LAKE COUNTY, OREGON

RECEIVED
RECEIVED
MAY 28 2021
OWRD
OWRD

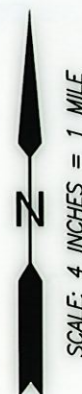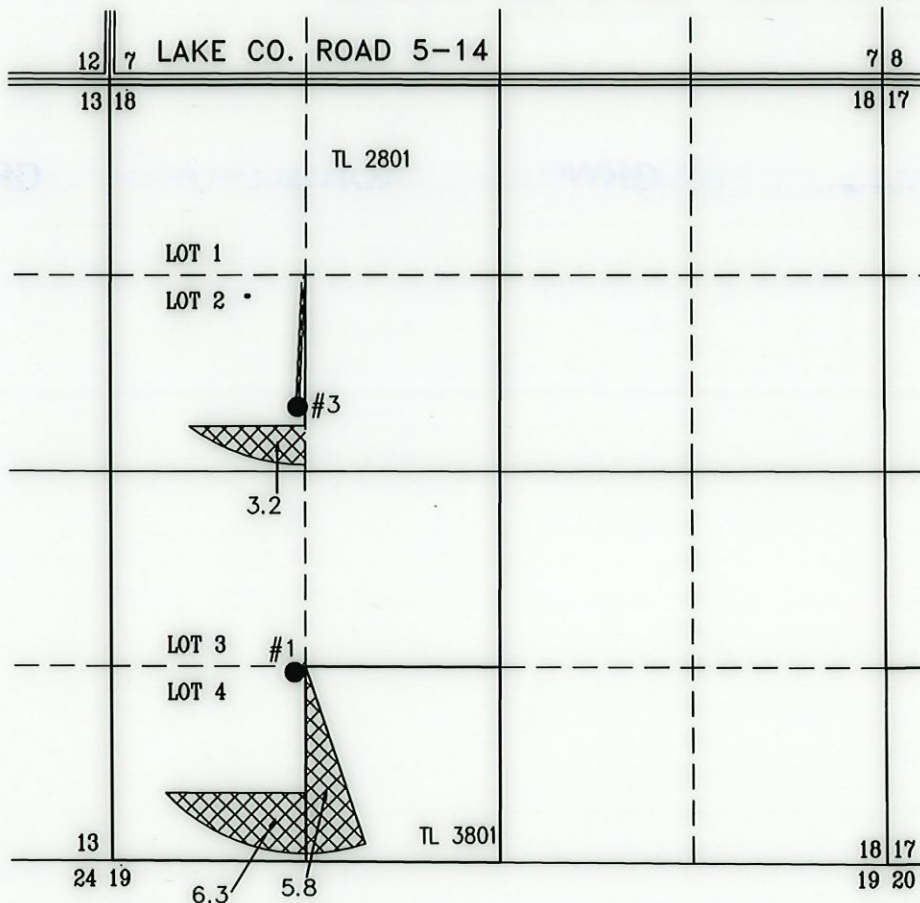

● #3
EXISTING WELL (LAKE 1136) TRANSFER:
T-12468
2240' SOUTH & 1290' EAST FROM THE
NW CORNER SECTION 18. FLOWMETER IS
LOCATED 3 FEET WEST FROM CENTER
PIVOT SPRINKLER.

● #1
EXISTING WELL (LAKE 1135)
4040' SOUTH & 1240' EAST FROM THE NW CORNER
SECTION 18. FLOWMETER LOCATED 6 FEET WEST
FROM CENTER PIVOT SPRINKLER.

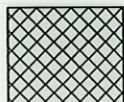

15.3 ACRES 'IR' FROM POA 1
& 3 & C#75828, AS SHOWN



RENEWAL DATE: 12/31/2022

THIS MAP IS FOR THE PURPOSE OF LOCATING A WATER
RIGHT ONLY AND HAS NO INTENT TO PROVIDE LEGAL
DIMENSIONS OR THE LOCATION OF PROPERTY LINES

PREPARED FOR:

SANDRA OVERTON
P.O. BOX 556
CHRISTMAS VALLEY, OR 97641

PREPARED BY:



ALL POINTS ENGINEERING AND SURVEYING, INC.
P.O. BOX 767
(541) 548-5833
TERREBONNE, OR 97760
www.APEandS.com

CLAIM OF BENEFICIAL USE MAP

TO CHANGE PLACE OF USE PER

APP T-12468

GILLETTE LIVING TRUST



SECTION 18, TOWNSHIP 27 SOUTH, RANGE 18 EAST, W.M.

TAX LOT: 2801 LAKE COUNTY, OREGON

RECEIVED

MAY 28 2021

OWRD

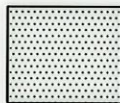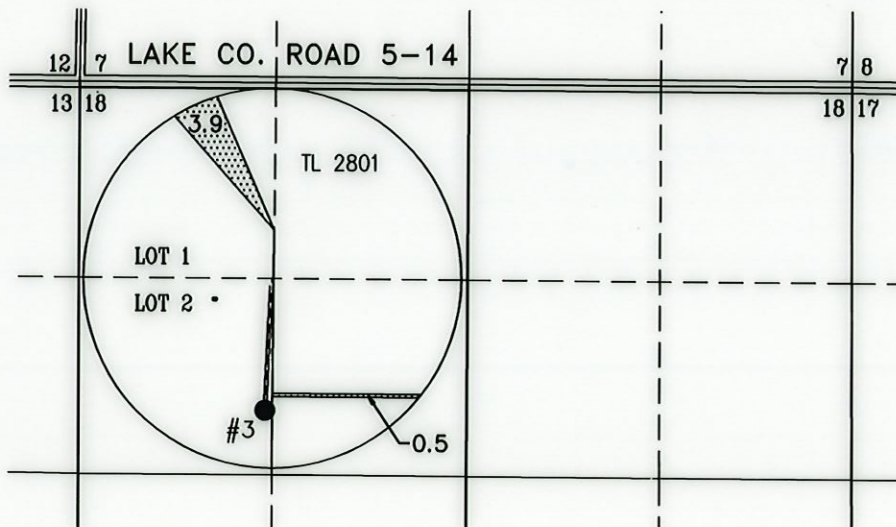

4.4 ACRES 'IS' FROM POA 3
& C#75828, AS SHOWN

- #3
EXISTING WELL (LAKE 1136) TRANSFER: T-12468
2240' SOUTH & 1290' EAST FROM THE NW CORNER
SECTION 18. FLOWMETER IS LOCATED 3 FEET WEST
FROM CENTER PIVOT SPRINKLER.



RENEWAL DATE: 12/31/2022

THIS MAP IS FOR THE PURPOSE OF LOCATING A WATER
RIGHT ONLY AND HAS NO INTENT TO PROVIDE LEGAL
DIMENSIONS OR THE LOCATION OF PROPERTY LINES

PREPARED FOR:

SANDRA OVERTON
P.O. BOX 556
CHRISTMAS VALLEY, OR 97641

PREPARED BY:



ALL POINTS ENGINEERING AND SURVEYING, INC.
P.O. BOX 767
(541) 548-5833
TERREBONNE, OR 97760
www.APEandS.com