

CLAIM OF BENEFICIAL USE MAP


TO CHANGE PLACE OF USE AND
CHANGE POINT OF APPROPRIATION PER
APP T-12468
GILLETTE LIVING TRUST

SECTION 18, TOWNSHIP 27 SOUTH, RANGE 18 EAST, W.M.
TAX LOTS: 2801 & 3801 LAKE COUNTY, OREGON

RECEIVED

MAY 28 2021


OWRD

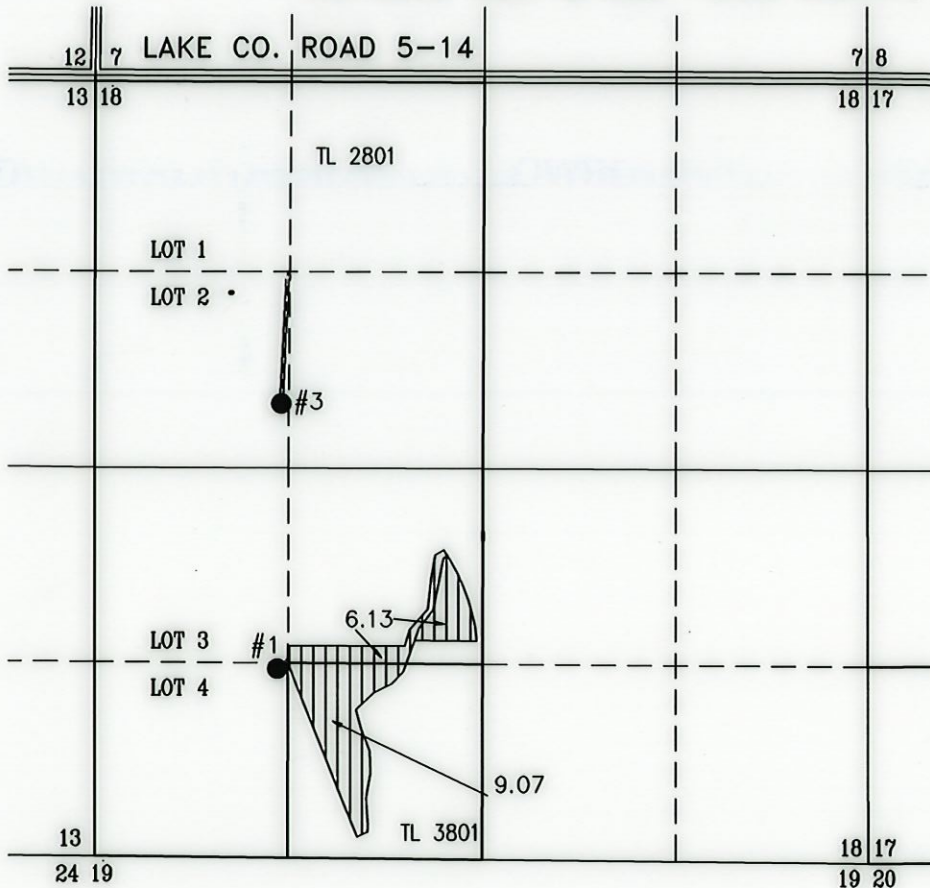

- #1
EXISTING WELL (LAKE 1135)
4040' SOUTH & 1240' EAST FROM THE NW CORNER
SECTION 18. FLOWMETER LOCATED 6 FEET WEST
FROM CENTER PIVOT SPRINKLER.



15.2 ACRES 'IR' FROM POA 1
& C#75830, AS SHOWN

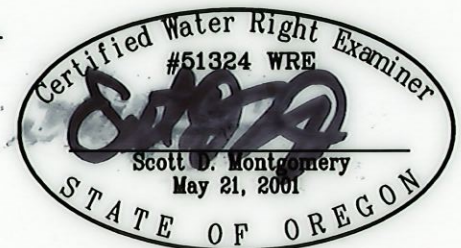

RENEWAL DATE: 12/31/2022

THIS MAP IS FOR THE PURPOSE OF LOCATING A WATER
RIGHT ONLY AND HAS NO INTENT TO PROVIDE LEGAL
DIMENSIONS OR THE LOCATION OF PROPERTY LINES

PREPARED FOR:

SANDRA OVERTON
P.O. BOX 556
CHRISTMAS VALLEY, OR 97641

PREPARED BY:



ALL POINTS ENGINEERING AND SURVEYING, INC.
P.O. BOX 767
(541) 548-5833
TERREBONNE, OR 97760
www.APEandS.com