


# CLAIM OF BENEFICIAL USE MAP

T-12079

TOWNSHIP 9 SOUTH, RANGE 20 EAST, SECTIONS 33 & 34, W.M.,  
TOWNSHIP 10 SOUTH, RANGE 20 EAST, SECTIONS 3 & 4, W.M.,  
WHEELER COUNTY, OREGON. JUNE, 2023

SCALE: 1" = 500'  
FOR 11x17" SHEETS

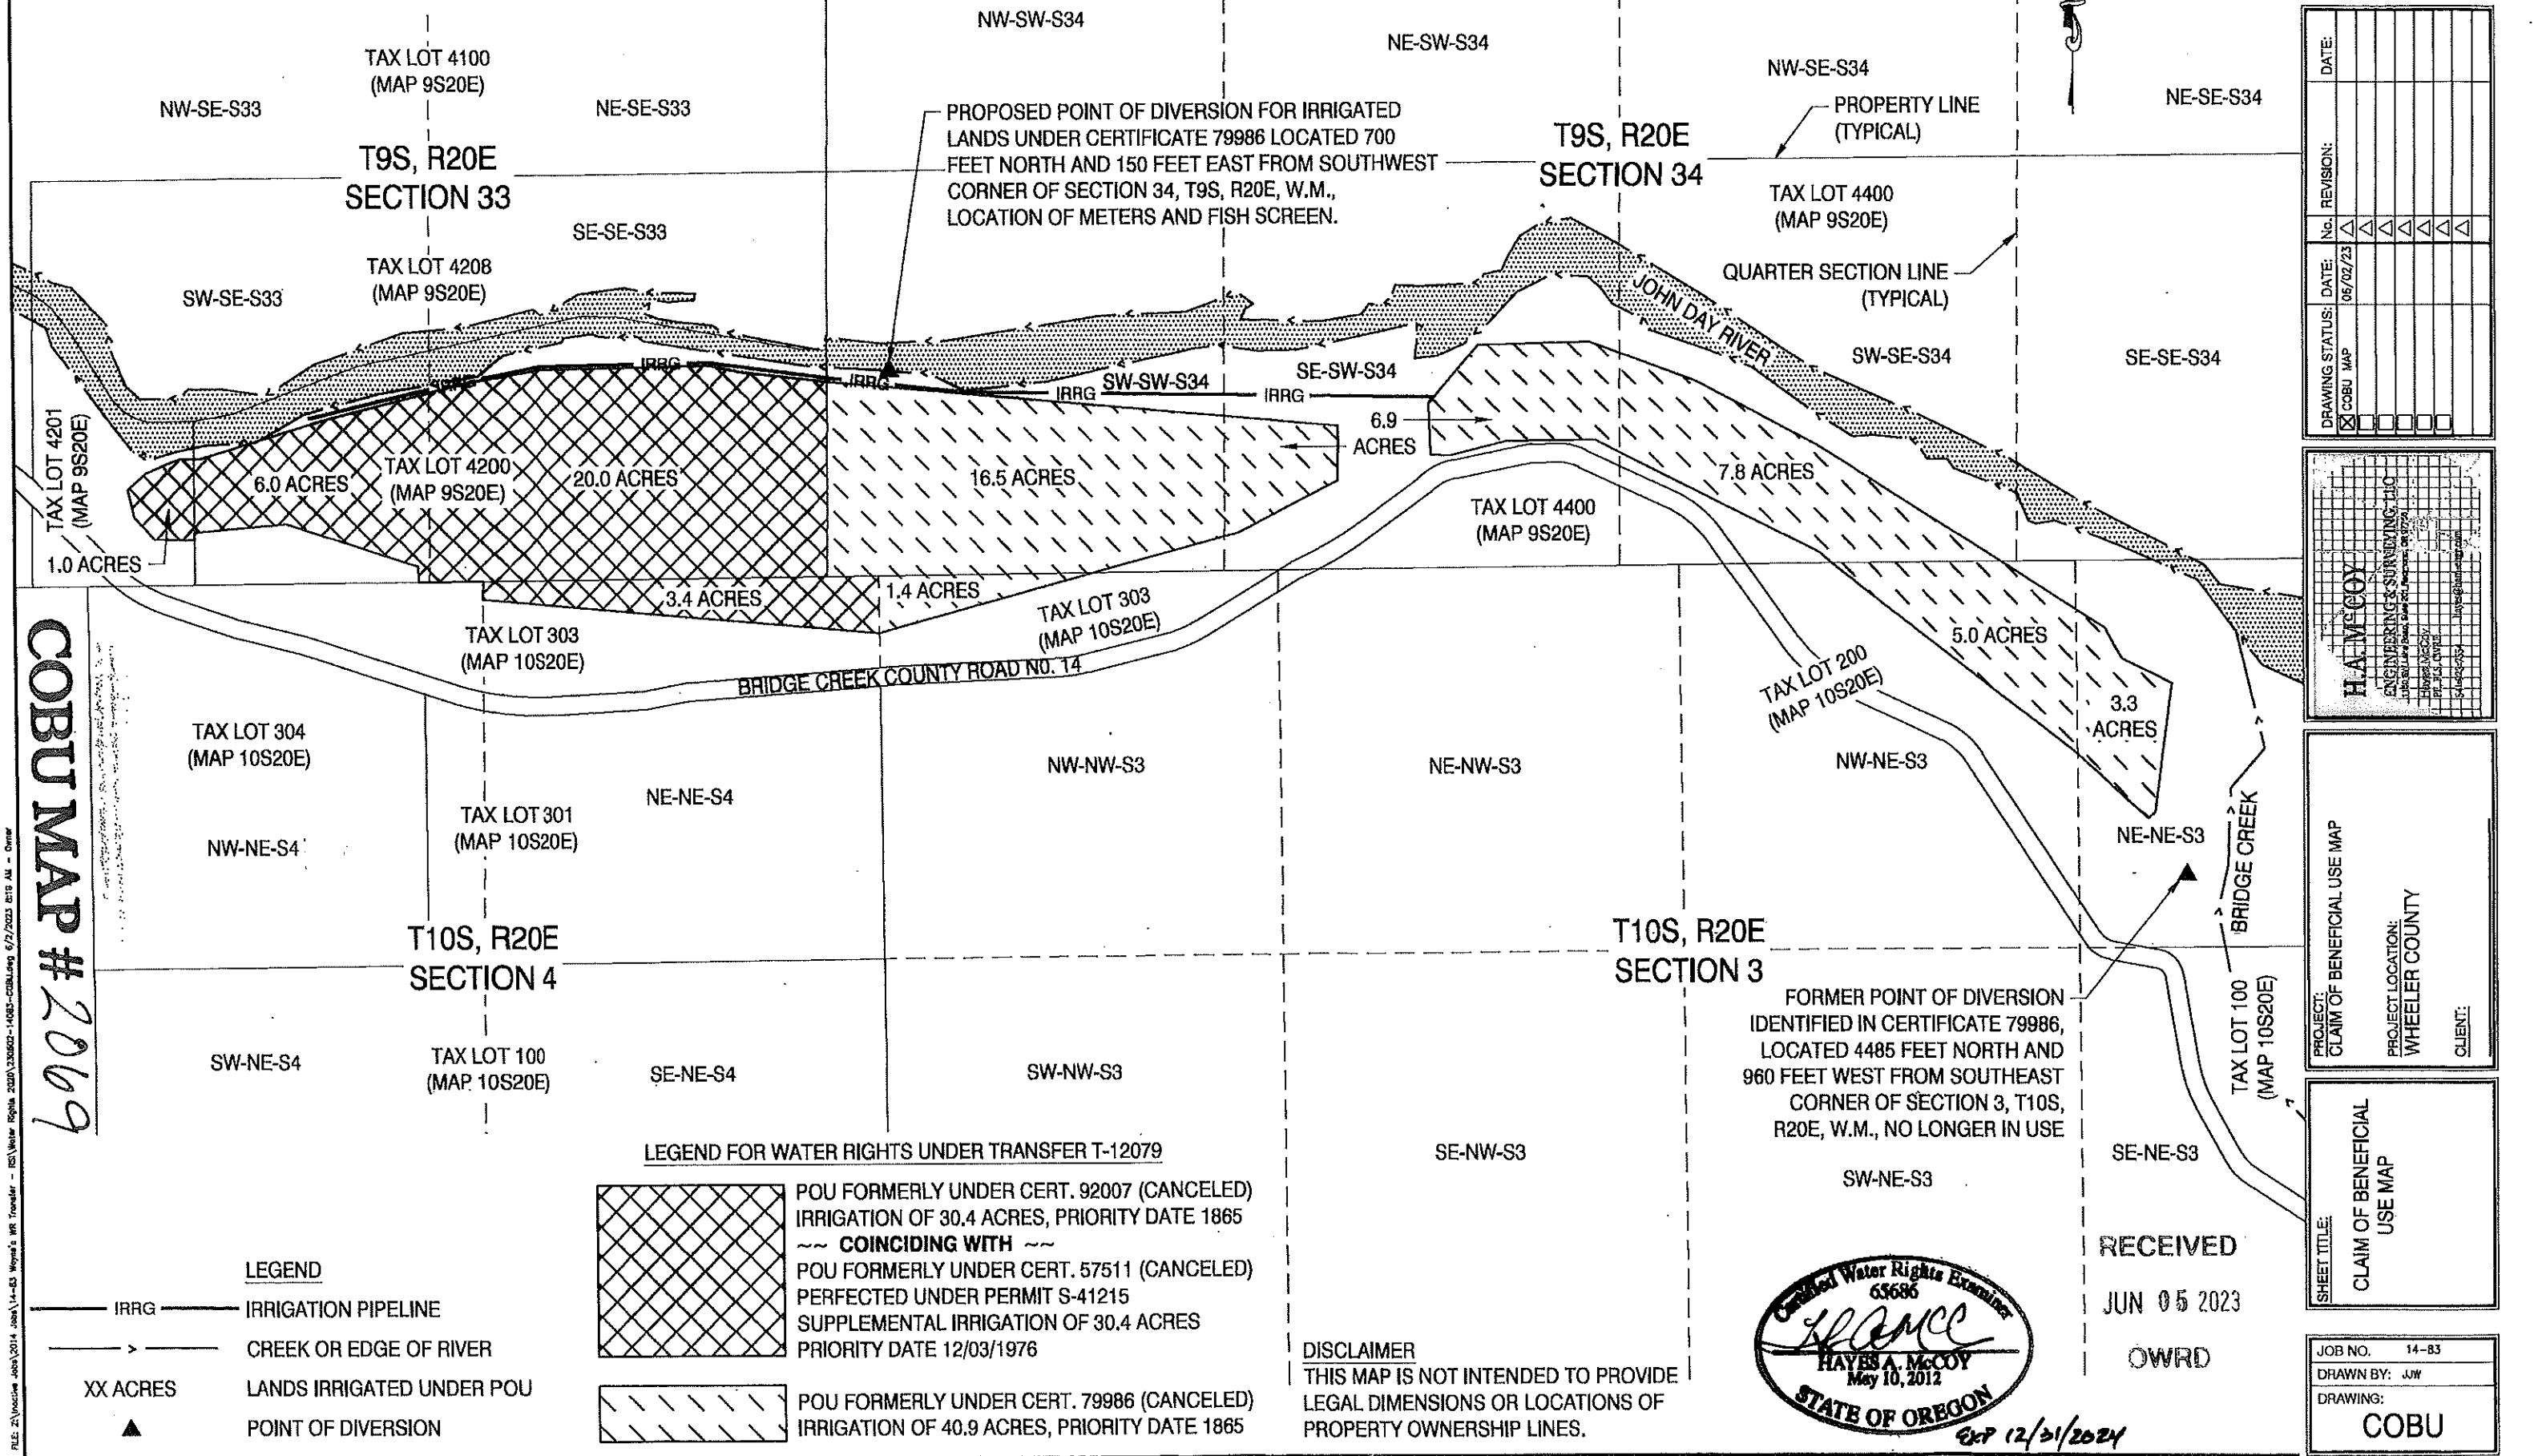

COBU MAP # 2069

FILE: Z:\Vocifer\John\2014\John\14-43\Wayne's\_WR\_Transfer - (NS) Water Rights\_2023\306002-1405-COBU.MXD 6/7/2023 8:15 AM - Owner


DRAWING STATUS:	COBU MAP	DATE:	05/02/23
REVISION:	No.	DATE:	
	1		
	2		
	3		
	4		
	5		

**HAYES A. MCCOY**  
ENGINEERING & SURVEYING, P.C.  

PROJECT: CLAIM OF BENEFICIAL USE MAP  
PROJECT LOCATION: WHEELER COUNTY  
CLIENT:

SHEET TITLE: CLAIM OF BENEFICIAL USE MAP

JOB NO. 14-83  
DRAWN BY: JJW  
DRAWING: COBU

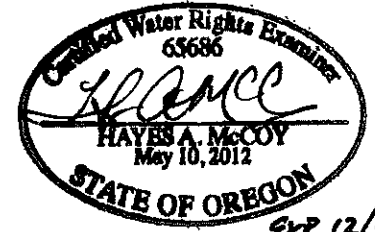

RECEIVED  
JUN 05 2023  
OWRD

**DISCLAIMER**  
THIS MAP IS NOT INTENDED TO PROVIDE LEGAL DIMENSIONS OR LOCATIONS OF PROPERTY OWNERSHIP LINES.

Exp 12/31/2024