


APPLICATION NO. G-13353
 PERMIT NO. G-12114 / TRANSFER NO. T-9850
 TOWNSHIP 3 SOUTH, RANGE 1 WEST, SECTION 7, NW1/4 NW1/4, SW1/4 NW1/4, SE1/4 NW1/4
 TOWNSHIP 3 SOUTH, RANGE 2 WEST, SECTION 12, NE1/4 SE1/4, NW1/4 SE1/4




THIS MAP IS NOT INTENDED TO PROVIDE LEGAL DIMENSIONS OR LOCATIONS OF PROPERTY OWNERSHIP LINES

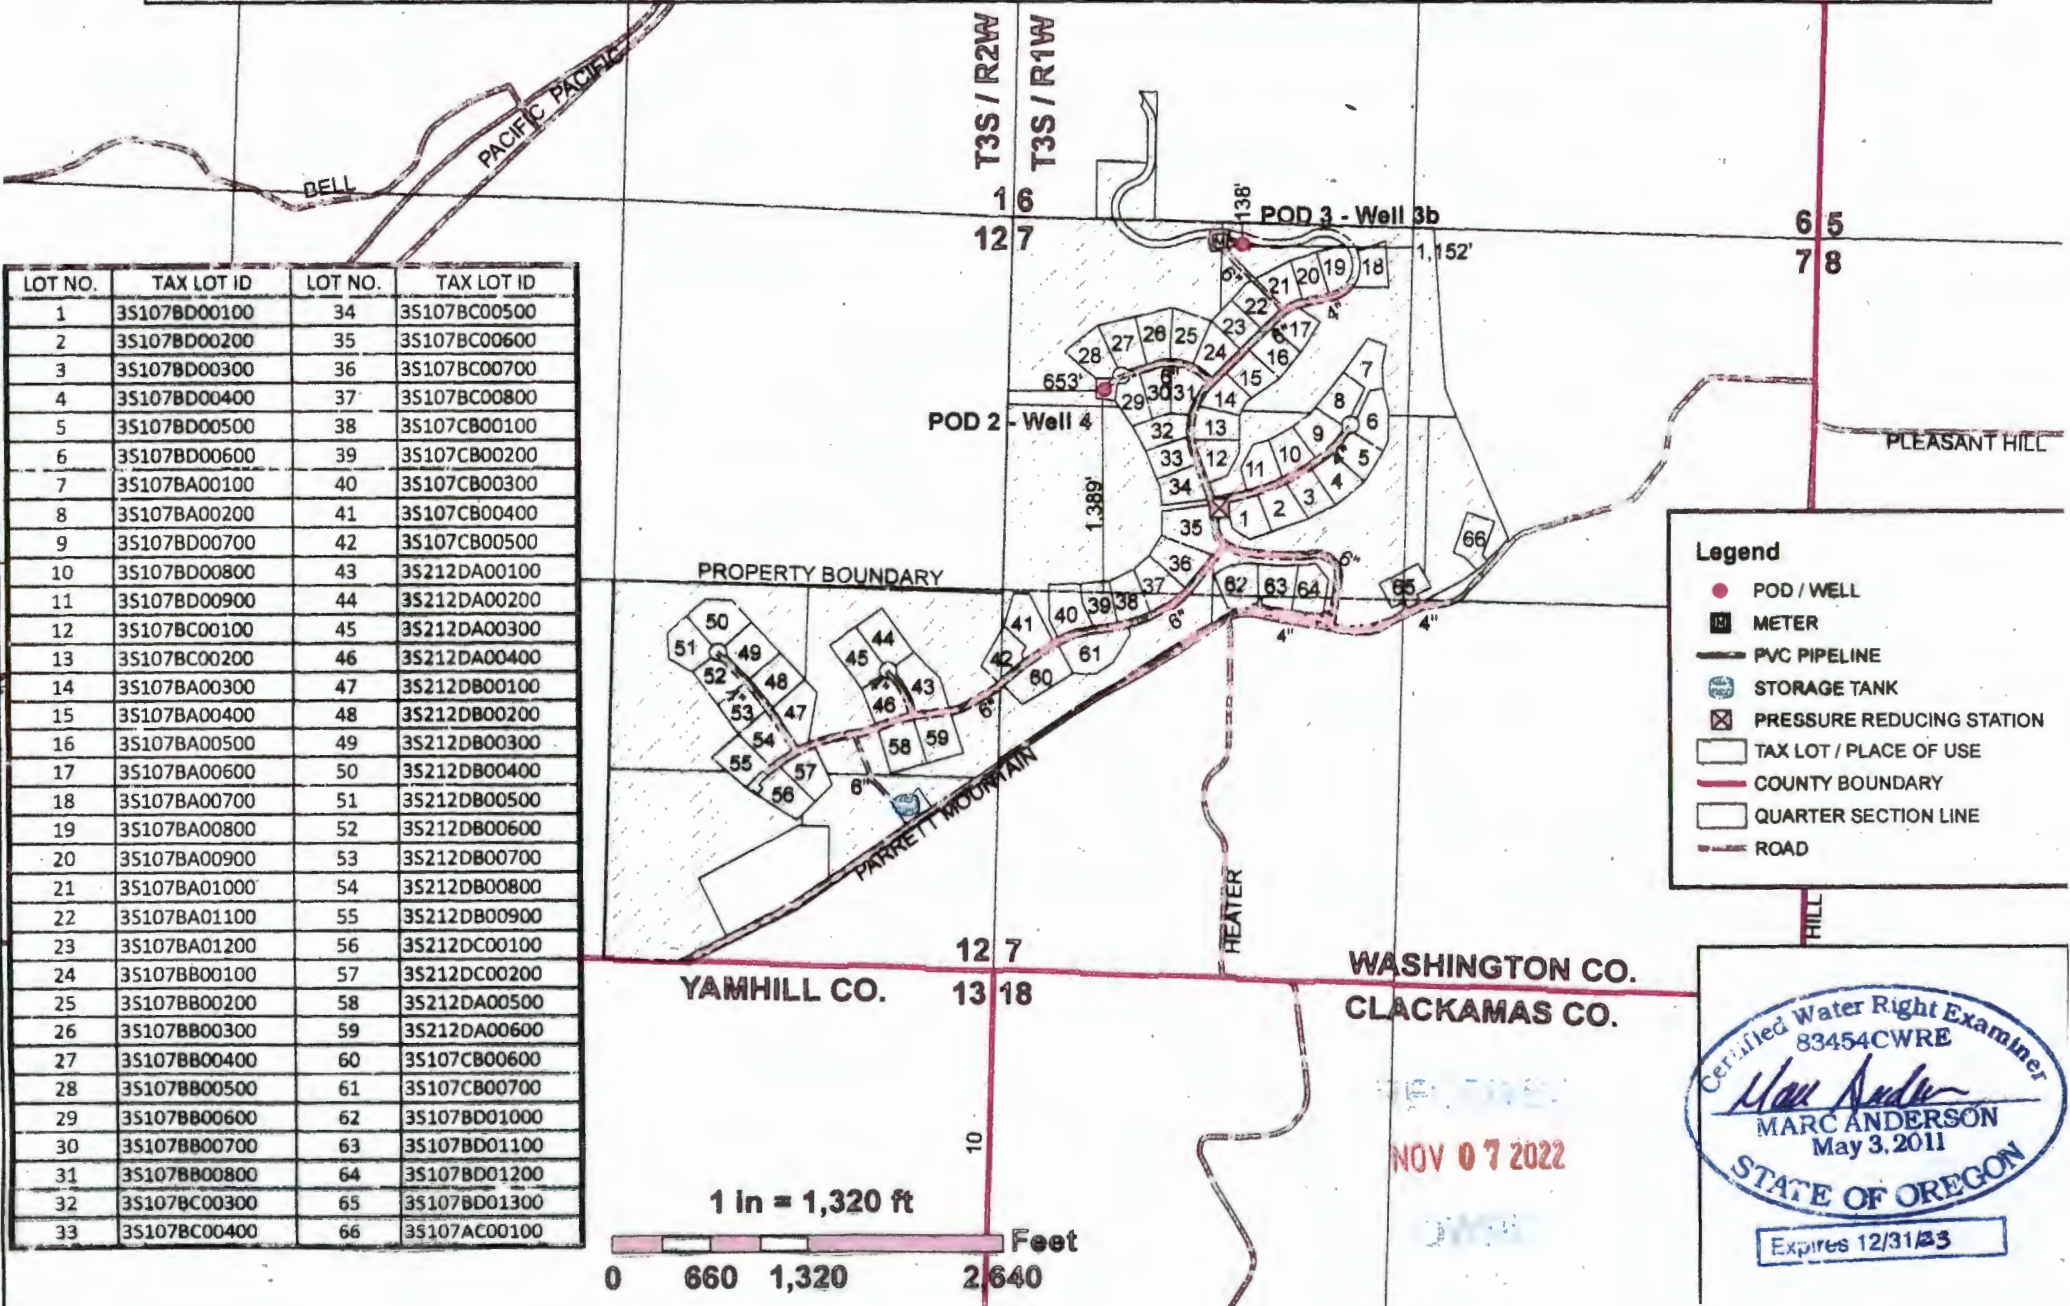

LOT NO.	TAX LOT ID	LOT NO.	TAX LOT ID
1	3S107BD00100	34	3S107BC00500
2	3S107BD00200	35	3S107BC00600
3	3S107BD00300	36	3S107BC00700
4	3S107BD00400	37	3S107BC00800
5	3S107BD00500	38	3S107CB00100
6	3S107BD00600	39	3S107CB00200
7	3S107BA00100	40	3S107CB00300
8	3S107BA00200	41	3S107CB00400
9	3S107BD00700	42	3S107CB00500
10	3S107BD00800	43	3S212DA00100
11	3S107BD00900	44	3S212DA00200
12	3S107BC00100	45	3S212DA00300
13	3S107BC00200	46	3S212DA00400
14	3S107BA00300	47	3S212DB00100
15	3S107BA00400	48	3S212DB00200
16	3S107BA00500	49	3S212DB00300
17	3S107BA00600	50	3S212DB00400
18	3S107BA00700	51	3S212DB00500
19	3S107BA00800	52	3S212DB00600
20	3S107BA00900	53	3S212DB00700
21	3S107BA01000	54	3S212DB00800
22	3S107BA01100	55	3S212DB00900
23	3S107BA01200	56	3S212DC00100
24	3S107BB00100	57	3S212DC00200
25	3S107BB00200	58	3S212DA00500
26	3S107BB00300	59	3S212DA00600
27	3S107BB00400	60	3S107CB00600
28	3S107BB00500	61	3S107CB00700
29	3S107BB00600	62	3S107BD01000
30	3S107BB00700	63	3S107BD01100
31	3S107BB00800	64	3S107BD01200
32	3S107BC00300	65	3S107BD01300
33	3S107BC00400	66	3S107AC00100

Legend

- POD / WELL
- METER
- PVC PIPELINE
- ⊕ STORAGE TANK
- ⊗ PRESSURE REDUCING STATION
- TAX LOT / PLACE OF USE
- COUNTY BOUNDARY
- QUARTER SECTION LINE
- ROAD

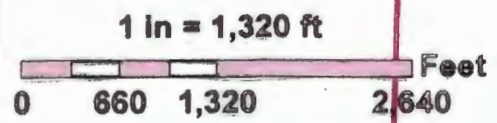

WASHINGTON CO.
 CLACKAMAS CO.

NOV 07 2022

Certified Water Right Examiner
 83454CWRE
Marc Anderson
 MARC ANDERSON
 May 3, 2011
 STATE OF OREGON
 Expires 12/31/23