
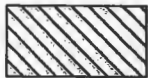


FINAL PROOF MAP

TO ADD A POINT OF APPROPRIATION &
CHANGE PLACE OF USE FOR T-11649
RICHARD & CAROLYN MENSCH

SECTION 5 IN TOWNSHIP 26 SOUTH, RANGE 19 EAST, W.M.
TAX LOTS: 500, 600, & 800

LAKE CO. ROAD 5-14E

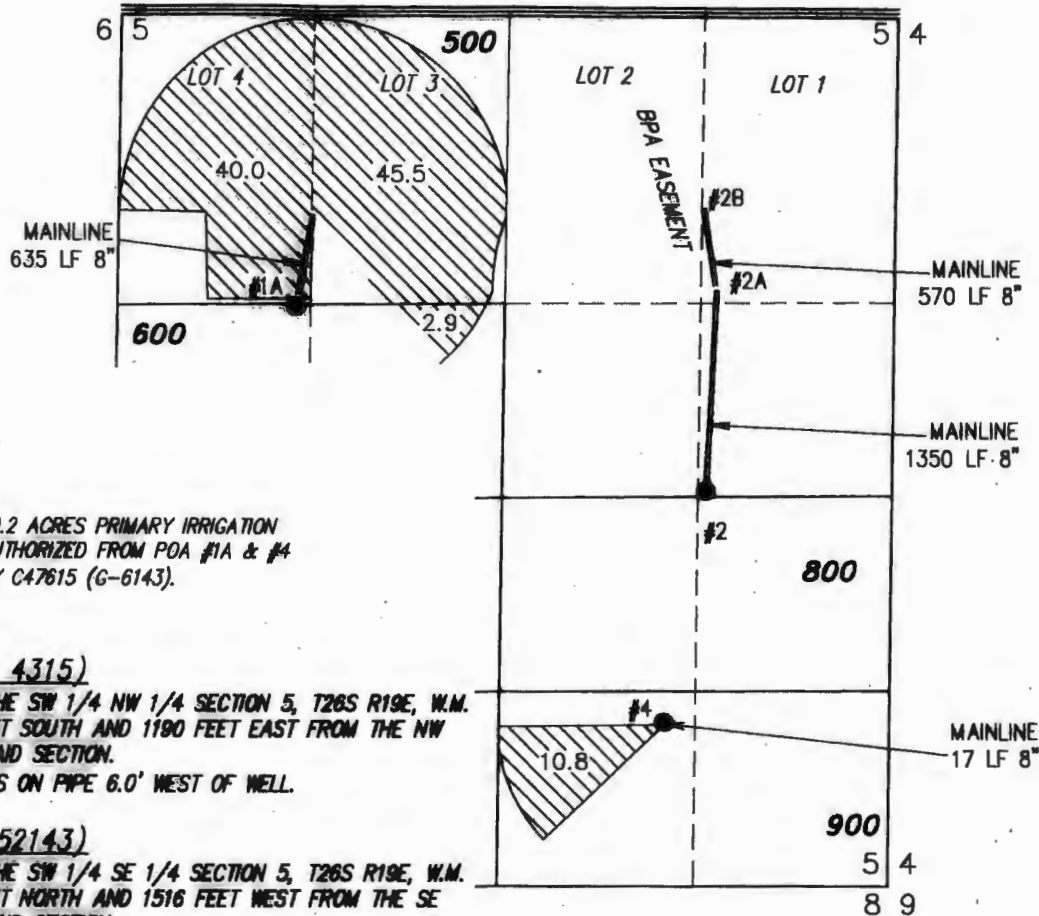


99.2 ACRES PRIMARY IRRIGATION
AUTHORIZED FROM POA #1A & #4
BY C47615 (G-6143).

● **#1A (LAKE 4315)**

LOCATED IN THE SW 1/4 NW 1/4 SECTION 5, T26S R19E, W.M.
AND 1890 FEET SOUTH AND 1190 FEET EAST FROM THE NW
CORNER OF SAID SECTION.
FLOW METER IS ON PIPE 6.0' WEST OF WELL.

● **#4 (LAKE 52143)**

LOCATED IN THE SW 1/4 SE 1/4 SECTION 5, T26S R19E, W.M.
AND 1088 FEET NORTH AND 1516 FEET WEST FROM THE SE
CORNER OF SAID SECTION.
FLOW METER IS ON PIPE 8.0' SOUTH OF WELL.

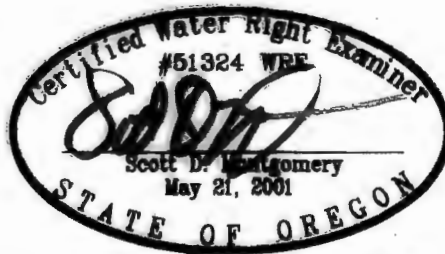

RENEWAL DATE: 12/31/2016

THIS MAP IS FOR THE PURPOSE OF LOCATING A WATER
RIGHT ONLY AND HAS NO INTENT TO PROVIDE LEGAL
DIMENSIONS OR THE LOCATION OF PROPERTY LINES.

PREPARED FOR:

RICHARD & CAROLYN MENSCH
P.O. BOX 628
CHRISTMAS VALLEY, OR 97641

PREPARED BY:



ALL POINTS ENGINEERING AND SURVEYING, INC.
P.O. BOX 767
(541) 548-5833
TERREBONNE, OR 97760
www.APEandS.com