

Surveyed Oct 29, 2018

T. 22 S., R. 21 E., W. M.

RECEIVED

JAN 11 2020

OWRD

Claim of Beneficial Use Map
for
Stephen & Clancy Roth


App G-16895

Per G-17047

T-11506

⊗ Irrigation 803 $\frac{1}{2}$ acres,
Rolyat 251 $\frac{1}{2}$ Tinner 155 $\frac{1}{2}$
Army 198 $\frac{1}{2}$ Rimrock 199 $\frac{1}{2}$

Scale 1" = 1320'
(4" = 1 mile)

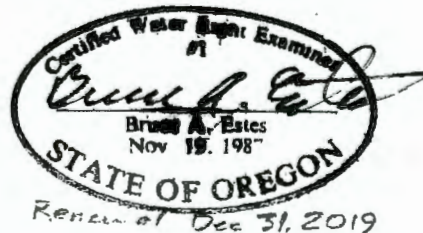

This map is for the purpose of
locating a water right only
and has no intent to provide
legal dimensions or the location
of property lines.

ESTES SURVEYS, LLC

PO Box 17519
Salem, OR 97305-7519
(503) 566-7983

80382 Arnold Rd
Bend, OR 97702
(541) 382-7391