


A PORTION OF THE NORTH 1/2, SECTION 1  
TOWNSHIP 1 SOUTH, RANGE 2 EAST, W.M.

# CLAIM OF BENEFICIAL USE MAP FOR CITY OF PORTLAND PARKS & RECREATION

PERMIT G-15869  
APPLICATION G-16195  
PARKLANE PARK  
SITUATED IN TAX LOTS 100, 200, 600  
IN SECTION 1, T1S, R2E, W.M.  
CITY OF PORTLAND  
MULTNOMAH COUNTY, OREGON  
JANUARY 2016



SCALE: 1" = 400'

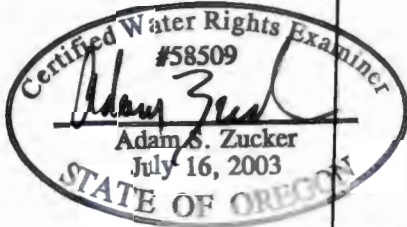

Expiration Date: 6-30-16

RECEIVED BY OWRD

MAR 31 2016

SALEM, OR

NW 1/4, NE 1/4, SEC. 1

WELL IS LOCATED 891 FEET NORTH AND 940 FEET EAST OF THE C 1/4 SECTION 1

SW 1/4, NE 1/4, SEC. 23

SE 1/4, NW 1/4, SEC. 1

WATER METER IS LOCATED 661 FEET NORTH AND 1091 FEET EAST OF C 1/4 SECTION 1

C 1/4 SEC. 1

THIS MAP IS TO IDENTIFY A PROPOSED WATER RIGHT LOCATION. IT IS NOT TO BE USED TO LOCATE PROPERTY BOUNDARIES.

**LEGEND:**

- SECTION LINE
- 1/4, 1/4 SECTION LINE
- - - - - PARKLANE PARK BOUNDARY

PREPARED FOR:  
CITY OF PORTLAND  
PARKS AND RECREATION  
6437 SE DIVISION ST.  
PORTLAND, OR 97206  
BY: ADAM ZUCKER, CWRE  
(503) 274-2010