



Claim of Beneficial Use - ACM II Oregon 2, LLC - Transfer T-12744

T8S, R1W, W.M.

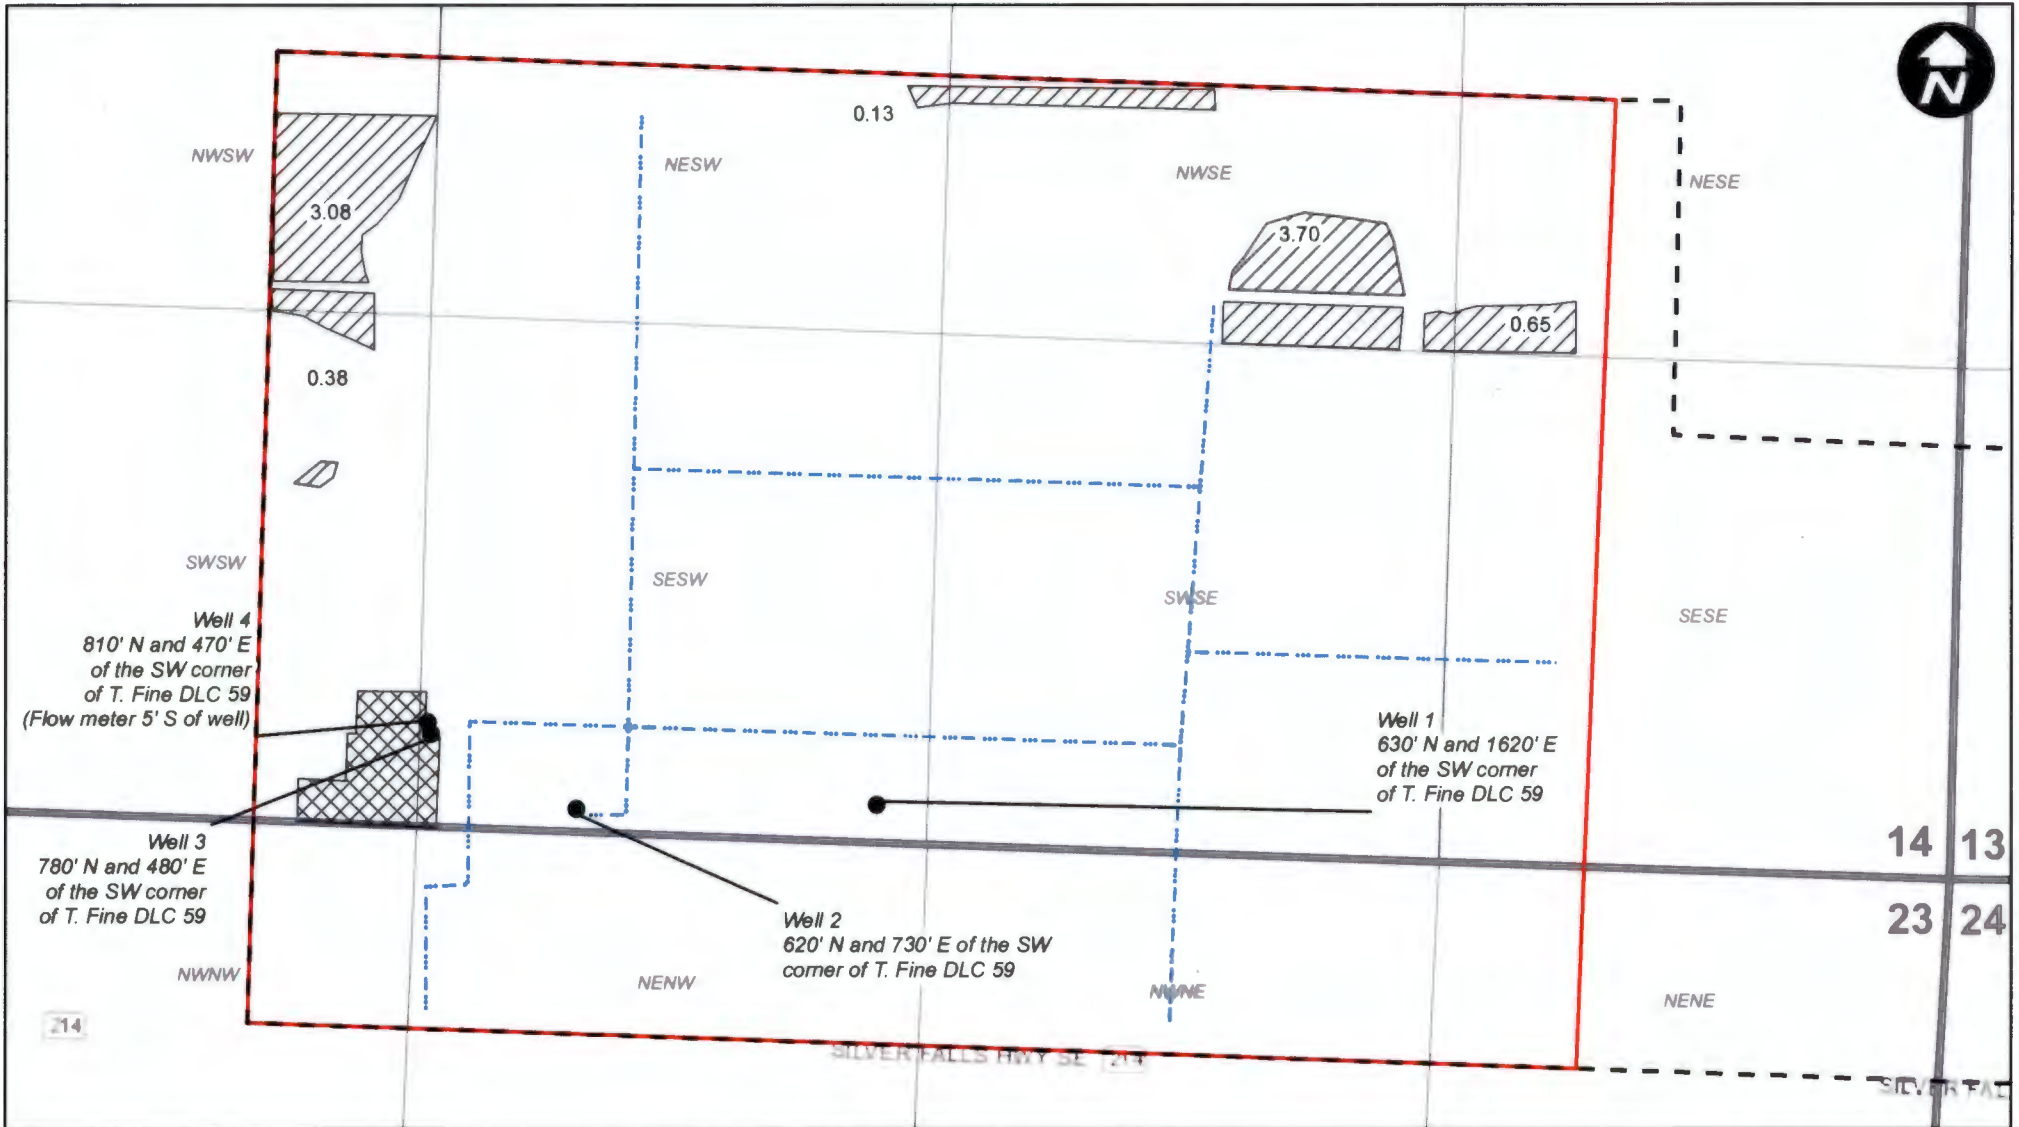

This map is not intended to provide legal dimensions or locations of property ownership lines.

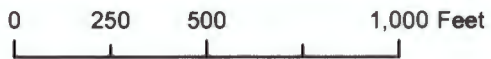

Legend

- Industrial POU
- Irrigation POU
- Mainline
- Taxlot 600
- T. Fine DLC 59



EXPIRES: 12/31/2022