

MAP TO ACCOMPANY APPLICATION TO CHANGE PLACE OF USE ON CERTIFICATES 20703 AND 20698 FOR CORY SHELMAN

TAX LOTS 200 & 402
IN SECTIONS 5 & 6, TOWNSHIP 26 SOUTH, RANGE 34 EAST, W.M.
HARNEY COUNTY, OREGON


RECEIVED

APR 18 2022


OWRD

▲ C 20698 - POD LOCATED IN THE NW 1/4
NE 1/4 SECTION 26, PER AERIAL IMAGERY OF
CREEK AND DIVERSION DITCHES. NO RECORD
COORDINATES HAVE BEEN NOTED.

▲ C 20703 - NO POD HAS BEEN NOTED.
WATER IS TAKEN FROM CUTS MADE IN THE
CREEK CHANNEL.

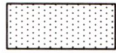-  160.0 ACRES IR FROM CERTIFICATE
20703 (V. 14, P.531), AS SHOWN.
-  160.0 ACRES IR FROM CERTIFICATE
20698 (V. 14, P.531), AS SHOWN.
-  151.5 ACRES IR REMAIN WITH CERTIFICATE
20703 (V. 14, P.531), AS SHOWN.
-  84.8 ACRES IR REMAIN WITH CERTIFICATE
20698 (V. 14, P.531), AS SHOWN.

SCALE 4" = 1 MILE

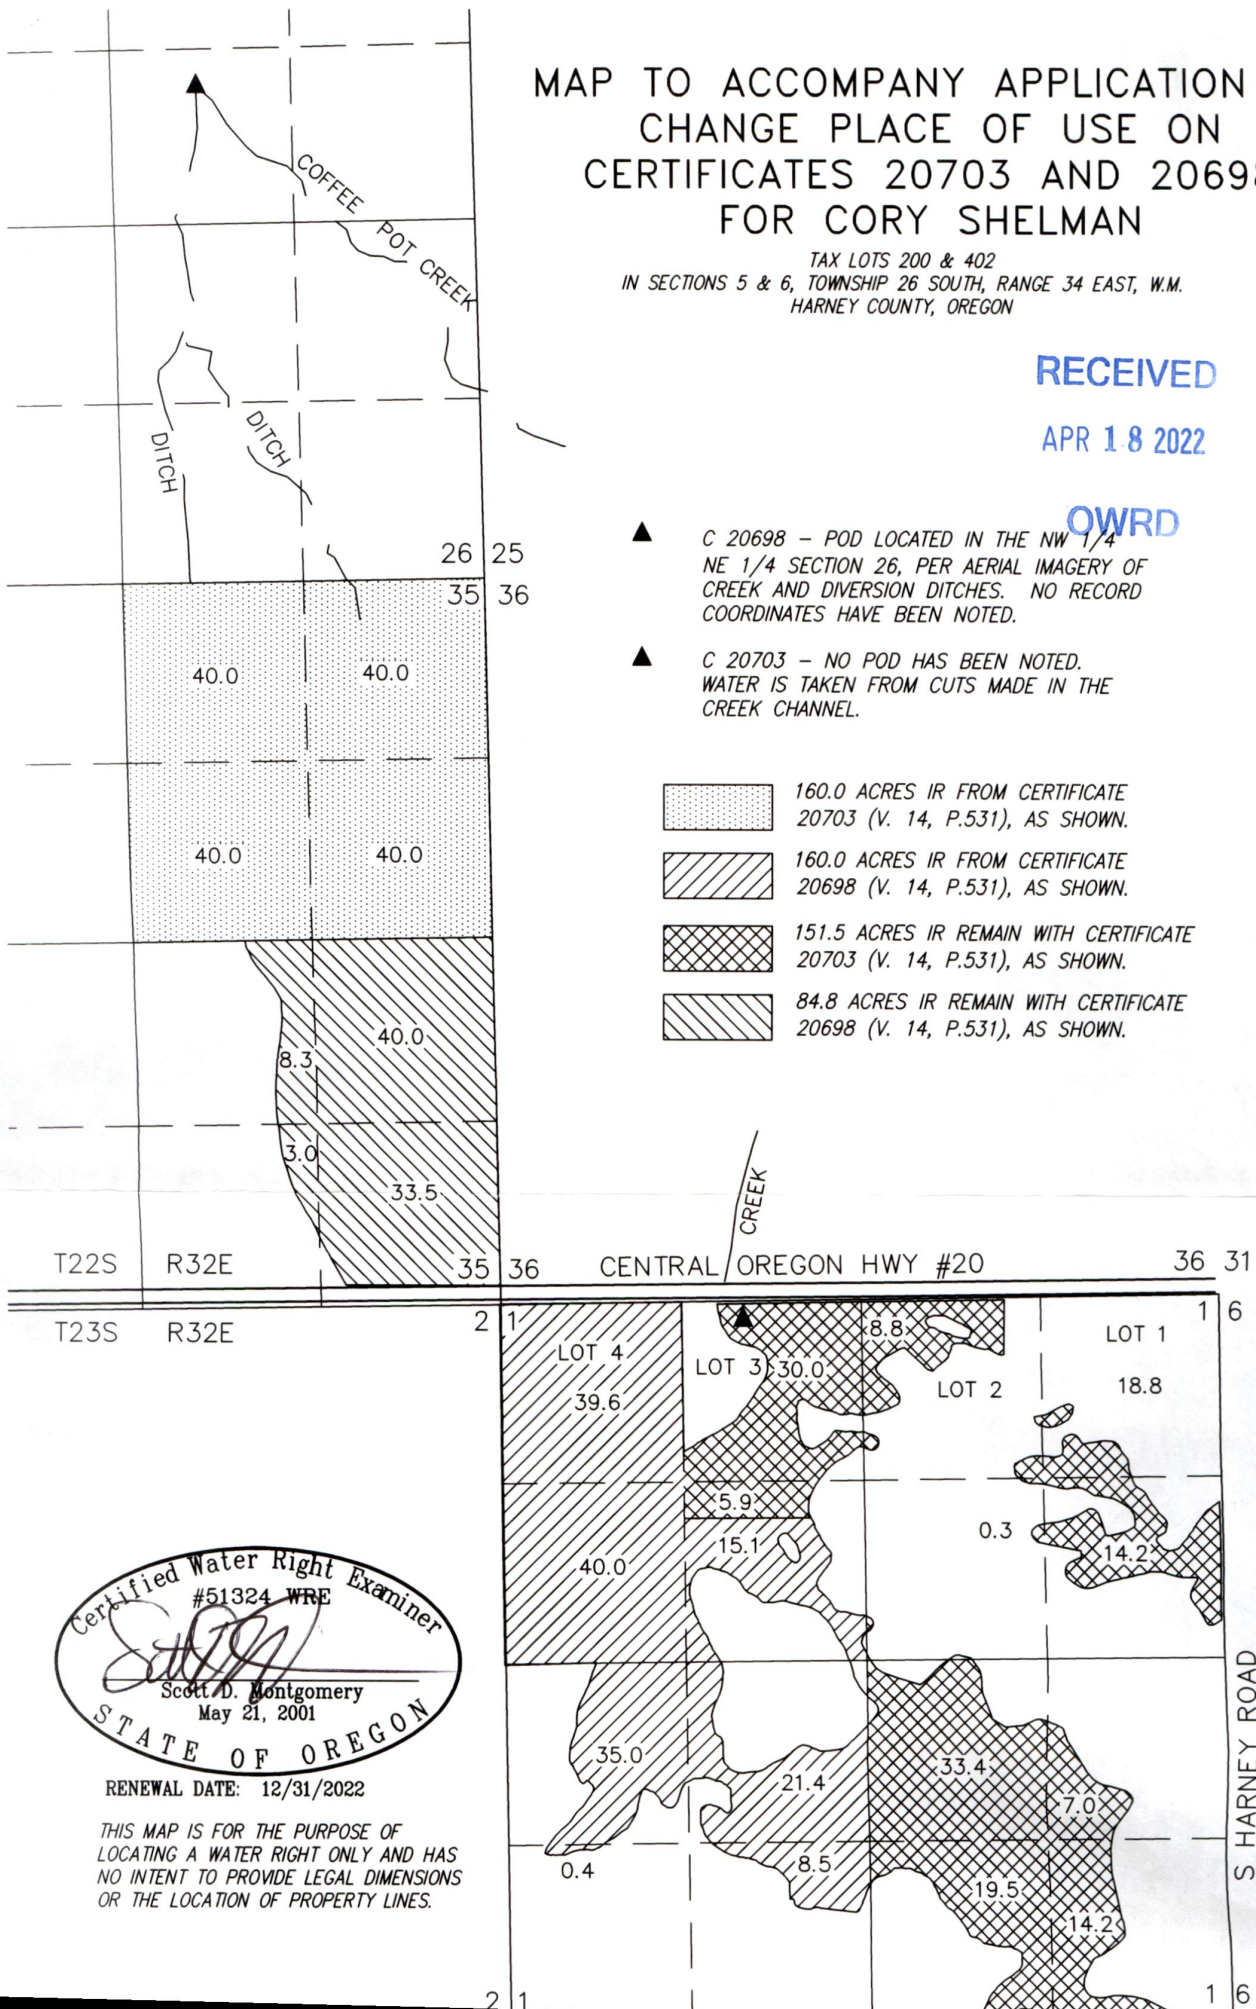

RENEWAL DATE: 12/31/2022

THIS MAP IS FOR THE PURPOSE OF
LOCATING A WATER RIGHT ONLY AND HAS
NO INTENT TO PROVIDE LEGAL DIMENSIONS
OR THE LOCATION OF PROPERTY LINES.

No

Final Proof

Map

Available