


T. 23S., R12W., W.M.

NW 1/4 SW 1/4 OF SECTION 9
COOS COUNTY

Wade Savik
1290 PENNY LANE NW
ALBANY, OR. 97321

PREPARATION OF THIS MAP IS FOR THE
PURPOSE OF IDENTIFYING THE LOCATION OF
THE WATER RIGHT ONLY. THERE IS NO INTENT
TO PROVIDE DIMENSIONS OR LOCATION OF
PROPERTY OWNERSHIP LINES.

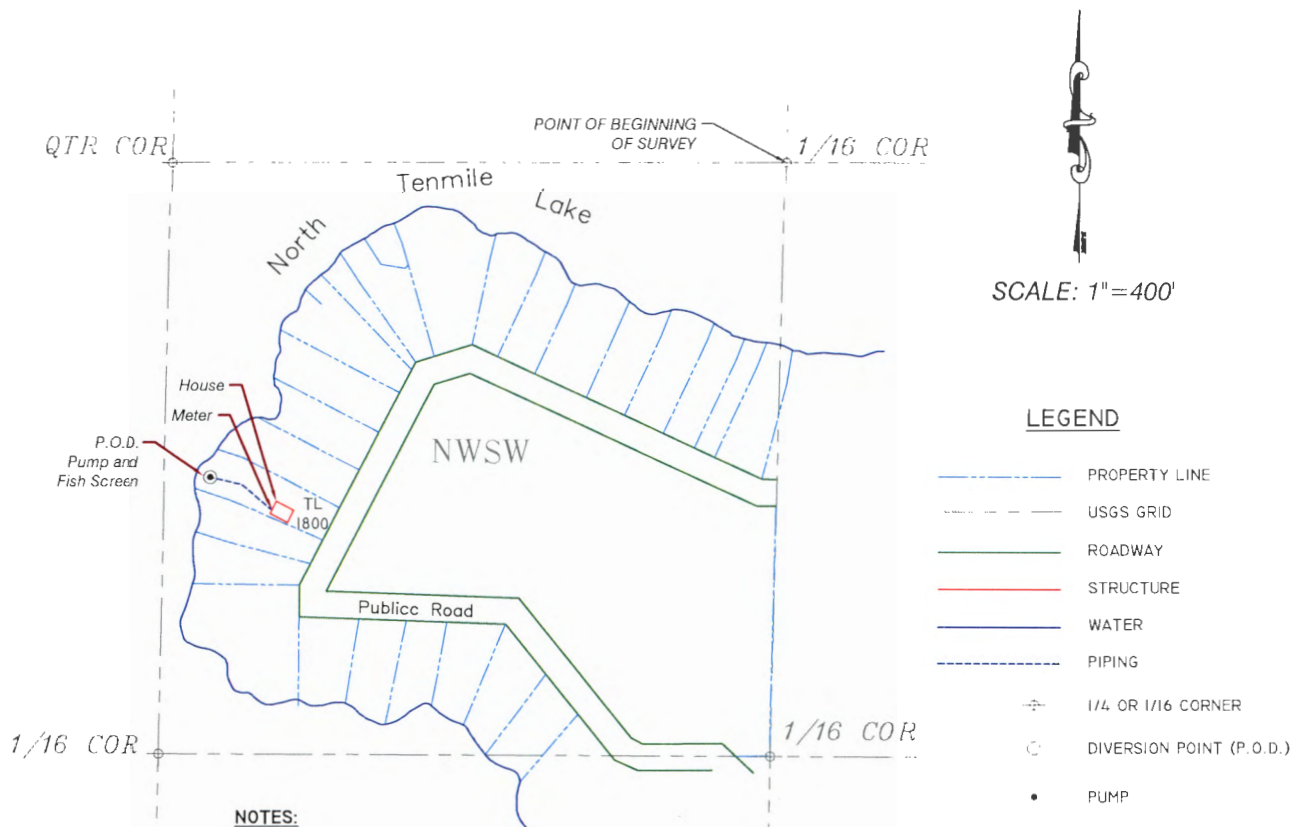

NOTES:

THE FISH SCREEN IS LOCATED ON
THE PUMP, WHICH IS ALSO THE P.O.D.

P.O.D. LOCATION:
660 FT SOUTH AND 1200 FT WEST
FROM THE C-W 1/16TH CORNER OF
SECTION 9.

Survey
AND CLAIM OF BENEFICIAL USE UNDER
APPLICATION No. S-85707
PERMIT No. S-54061

FILE PATH & NAME: E:\New Folder\personal\BK\SAENGKEO_SAVIK\2\SAVIK 052820.dwg

BK WATER RIGHT CONSULTING
PO Box 13434 Salem, Oregon 97309

Savik COBU

APPLICATION#: S-85707 PERMIT#: S-54061 AMENDMENT#: x-xxxxx SHEET 1 OF 1