


T22S, R30E, W.M.
Harney County, Oregon

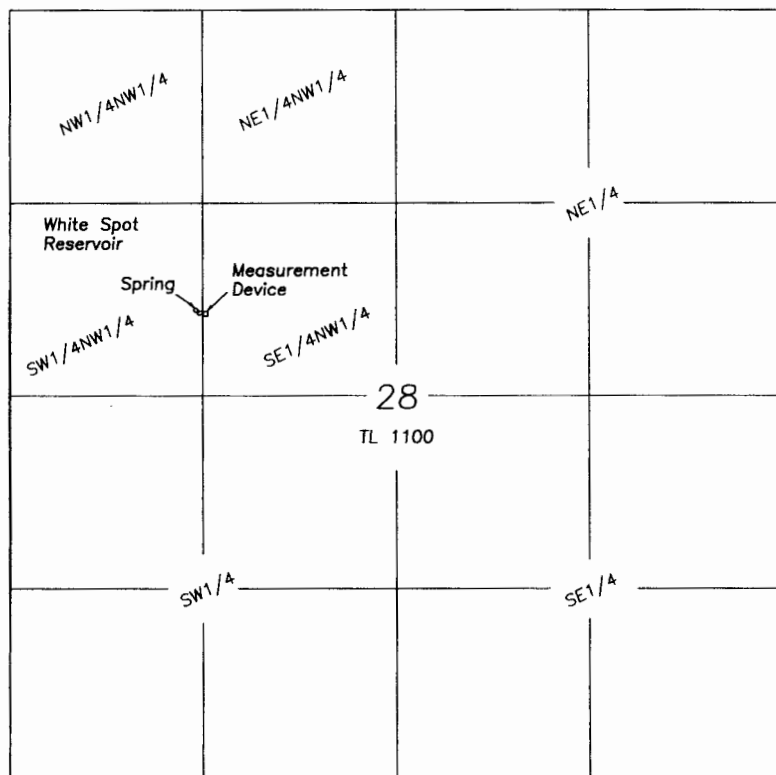

SCALE 1"=1320'

Spring is located 2050' South & 1270' East of the
NW corner of Section 28.

Measuring device is located 22' South & 42' East of the Spring

**FINAL PROOF SURVEY
CLAIM OF BENEFICIAL USE
WHITE SPOT SEEP RESERVOIR**

For

Bureau of Land Management
AUGUST 15, 2016

LEGEND

Application No. R-59639
Permit No. R-8074
Priority 12/21/1979

A portion of Tax Lot
22-30 TL1100

NOTE: Tax Lot 1100 is owned by the BLM
and is more that 6,000 acres.
Therefore only a small portion of the tax
lot boundary can be shown.

Prepared by

Cornerstone Surveying, Inc

P.O. BOX 33
JOHN DAY, OR. 97845
(541)575-1813

cornerstonesurvey@centurytel.net

RECEIVED BY OWRD

AUG 29 2016

SALEM, OR

NOTE: The preparation of this map
was for the purpose of identifying
the location of the proposed water
right and has no intent to provide
dimensions or location of property
ownership lines.

