



- LEGEND**
- IMPOUNDMENT
 - SECTION LINE
 - TAXLOT
 - - - SOURCE: JETTY CREEK
 - POINT OF DIVERSION

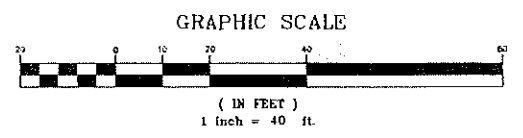

RECEIVED
SEP 29 2020
OWRD

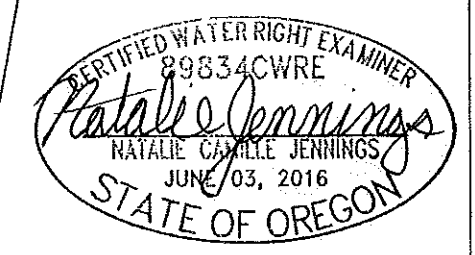

RENEWS:

TOWNSHIP: 2N
RANGE: 10W
SECTION: 17
WILLAMETTE MERIDIAN

DISCLAIMER: THIS MAP IS NOT INTENDED TO PROVIDE LEGAL DIMENSIONS OR LOCATIONS OF PROPERTY OWNERSHIP LINES.