


T.4S. R.1E. Section 31 T.5S. R.1E. Section 6, W.M.

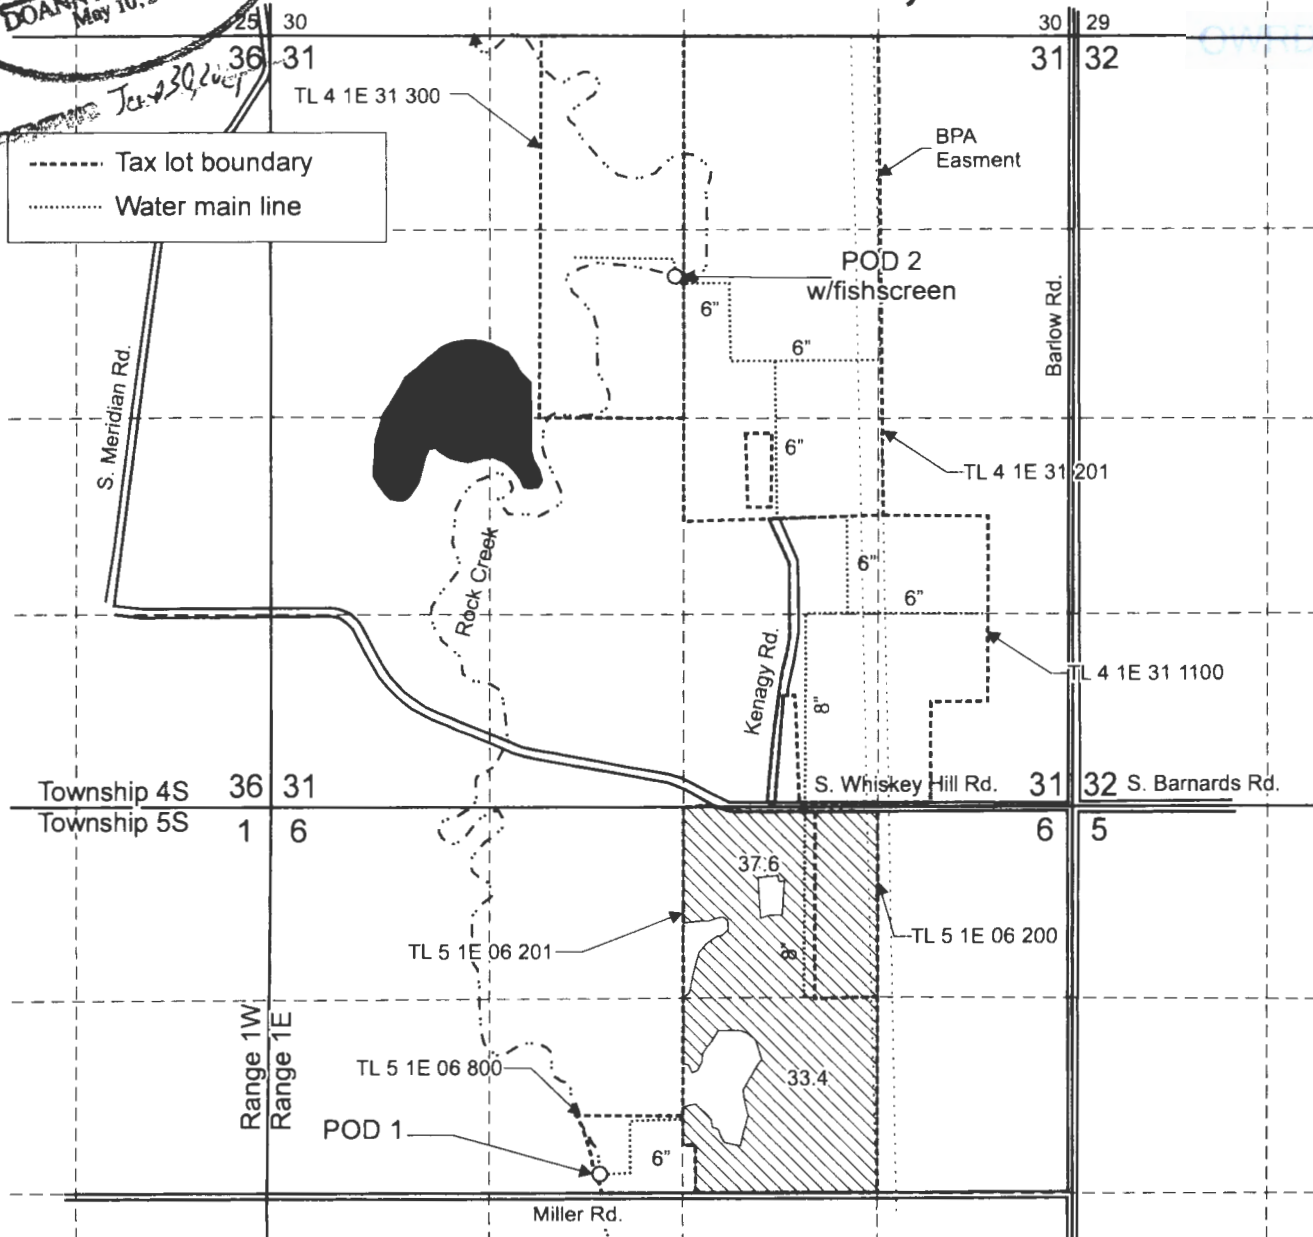

POD 1 is located in the SE 1/4, NW 1/4, Section 6, Township 5 South, Range 1 East W.M.

POD 2 is located 1,650 feet south and 2,705 feet west from the NE corner, Section 31.

 Area (71.0 Acres) irrigated under T-12952.

Scale: 1" = 1,320'



0 1,320
Feet

This map was prepared for the purpose of identifying the location of a water right only and is not intended to provide legal dimensions or location of property ownership lines.

Claim of Beneficial Use Map T-12952

Ken Lan LLC, c/o Jess Kenagy
T.4S. R.1E. Section 31,
T.5S. R.1E. Section 6, W.M.

Pacific Hydro-Geology Inc.

3/2020