


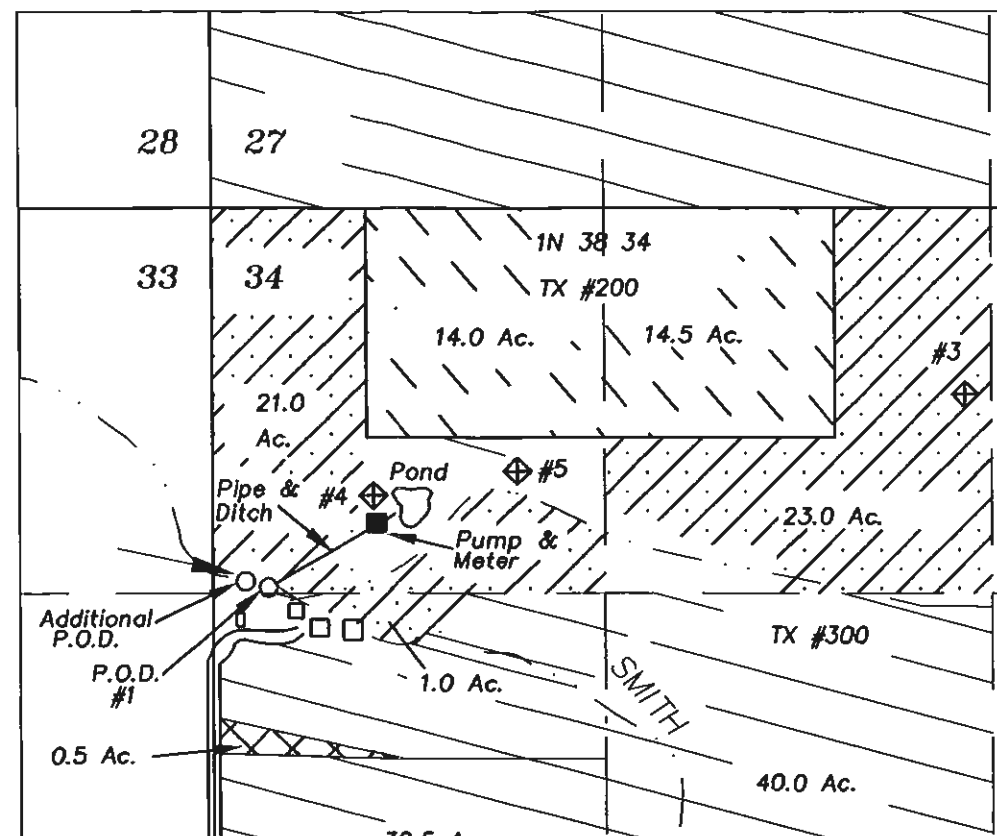


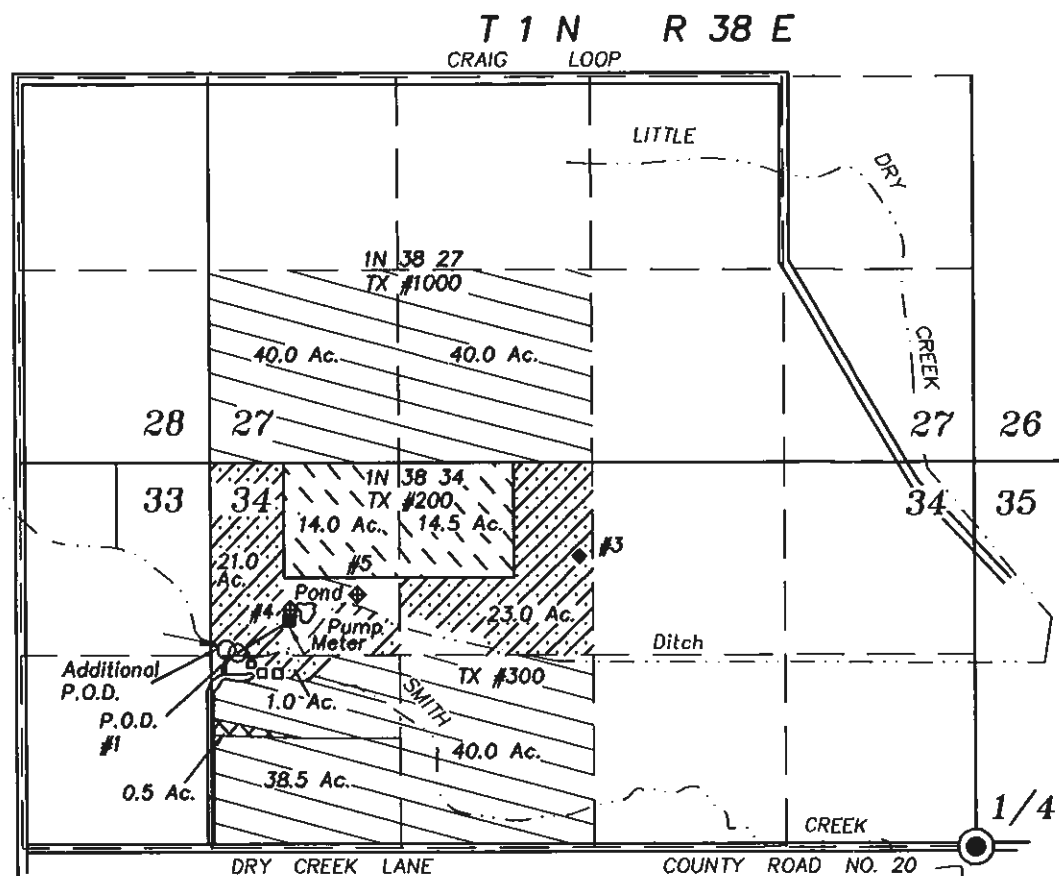


Lands irrigated by Certificate 36805 (0.5 Acres), with a change in point of diversion.

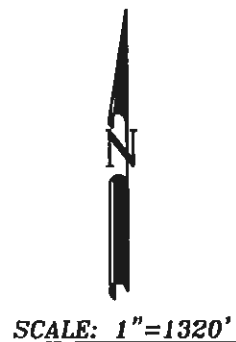

Lands irrigated by Primary Certificate 36804 priority 1964, and supplemental Certificate 46910 with a change of P.O.D. and consolidating P.O.A.s (sumps) along with change in place of use.

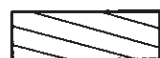

Lands irrigated by Permit 46910 with a change in P.O.D. and additional P.O.D. along with a change of Place of use.

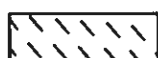

Lands irrigated by Certificate 6453 Smith Creek (1883 priority) with a change in P.O.D. and additional P.O.D. along with change of place of use.

◆ Sump Location and Number

Note: Mainlines are all portable.

Additional P.O.D. is located 1361' North and 5166' West of the East 1/4 corner of Section 34

P.O.D.#1 is located 1340' North and 5087' West of the East 1/4 corner of Section 34.


Meter (Metal Parshell Flume) is 1561' North and 4727' West of the East 1/4 corner of Section 34

SUMPS

#3 2000' feet North and 2730 feet West of the East 1/4 corner of Section 34.

#4 1638' feet North and 4718' feet West of the East 1/4 corner of Section 34.

#5 1740' feet North and 4250' feet West of the East 1/4 corner of Section 34.

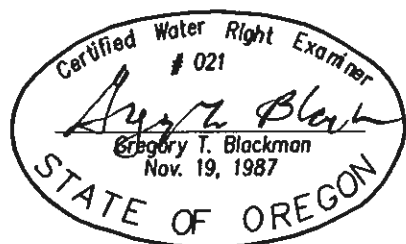

NOTE: The preparation of this map was for the purpose of identifying the location of the proposed water right and has no intent to provide dimensions or location of property ownership lines. Location information shown hereon was furnished by the applicant.

COBU MAP #0285

RECEIVED
SEP 04 2007
WATER RESOURCES DEPT
SALEM, OREGON

July 16, 2007

FINAL PROOF MAP FOR CHANGE OF POINT OF DIVERSION- PLACE OF USE ADDITIONAL POINT OF DIVERSION AND ADDITIONAL POINTS OF APPROPRIATION

FOR

Larry R. Davis

BY

BAGETT - GRIFFITH & BLACKMAN
2006 ADAMS AVENUE
LAGRANDE, OREGON 97850

Application No. T- 9556
Permit Number T- 9556