


T-8316, North Santiam School District 29J Claim of Beneficial Use

Township 9S, Range 1W, W.M.

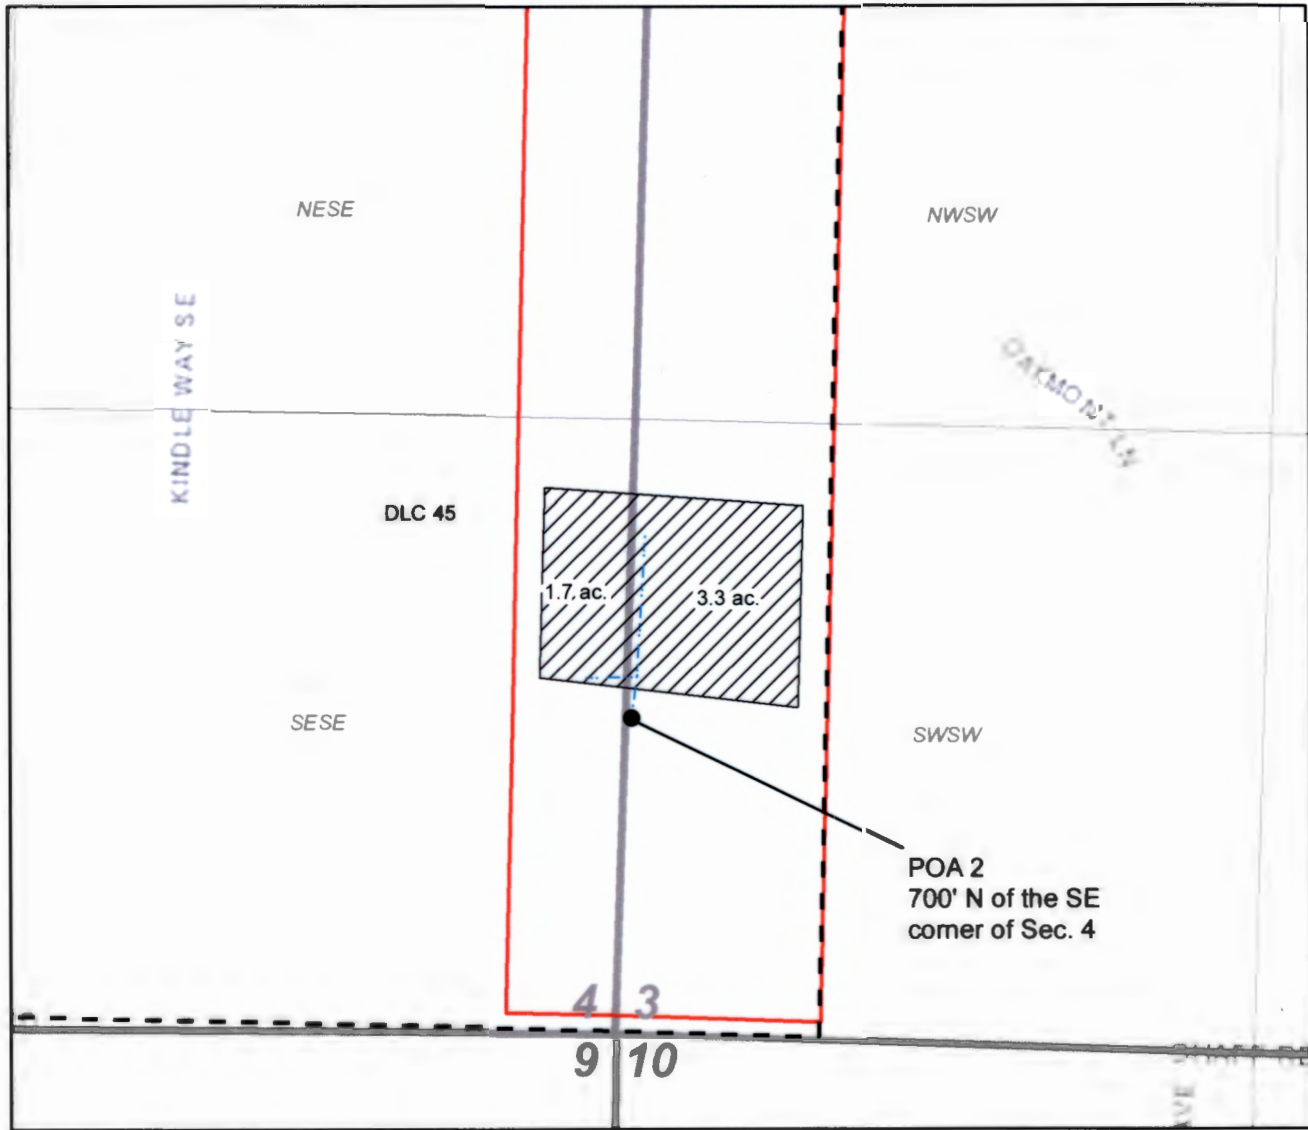

This map is not intended to provide legal dimensions or locations of property ownership lines.

1 inch = 400 feet



Legend

- Developed POU
- Buried Mainline
- Taxlot 100
- DLC



EXPIRES: 12-31-2022