

**FINAL PROOF SURVEY MAP FOR
T-9184 LOCATED IN SE1/4 OF
SECTION 11, T.15S., R.14E., W.M.,
CROOK COUNTY, OREGON
W.O. 05-3030**

SURVEY FOR



ROBERT E. FANKHAUSER
ROSE M. FANKHAUSER
P.O. BOX 28
POWELL BUTTE, OR
97753
(541)504-1381

SURVEY BY

ARMSTRONG SURVEYING
& ENGINEERING, INC.
378 NE SECOND ST.
PRINEVILLE, OR 97754
(541)447-7791

 PRIMARY - PRIORITY DEC. 11, 1978
GROUND WATER 0.8 AC.

 PRIMARY - PRIORITY DEC. 28, 1978
GROUND WATER 6.7 AC.

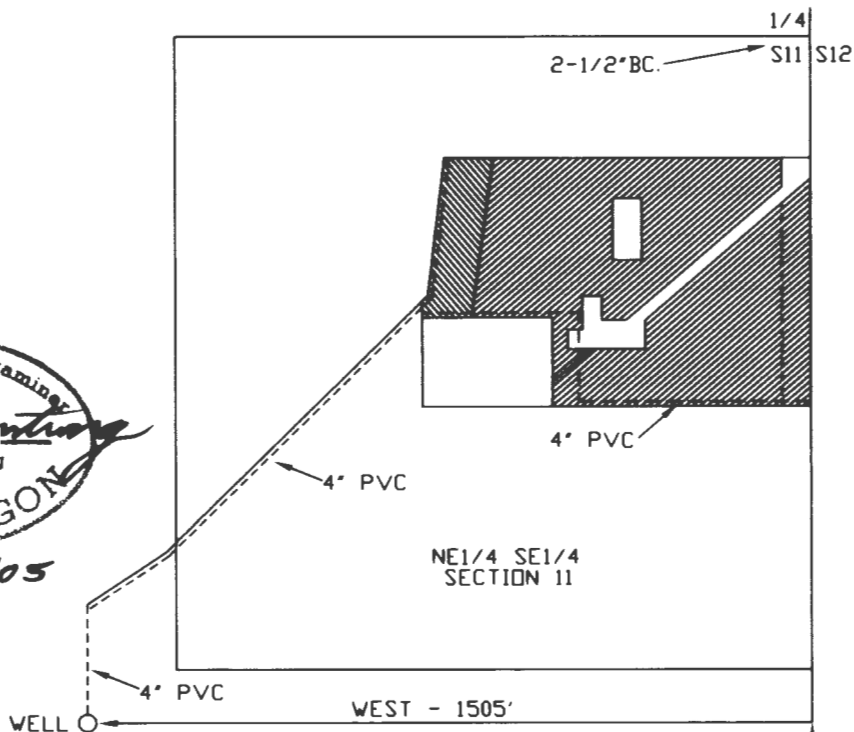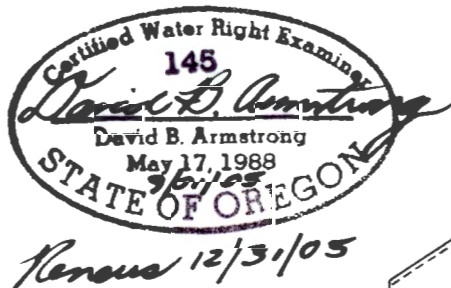


MAP NOTE

THE PREPARATION OF THIS MAP IS FOR THE PURPOSE OF IDENTIFYING THE LOCATION OF THE WATER RIGHT ONLY AND HAS NO INTENT TO PROVIDE DIMENSIONS OR LOCATIONS OF PROPERTY OWNERSHIP LINES.

SCALE
1" = 400'



NORTH - 1179'

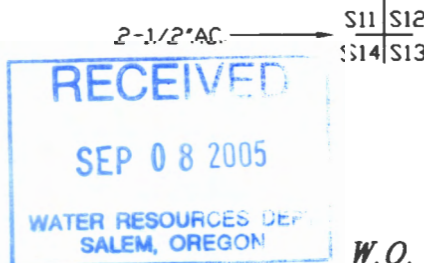

W.O. 05-3030