


FINAL PROOF SURVEY MAP IN THE NAME OF WALLACE DINSMORE AND PATRICIA L. DINSMORE TRUST

APPLICATION S-73100
R-73101

PERMIT 52761
R-12024

SECTIONS 33, 34 & 35, TOWNSHIP 25 SOUTH, RANGE 7 WEST, W.M.

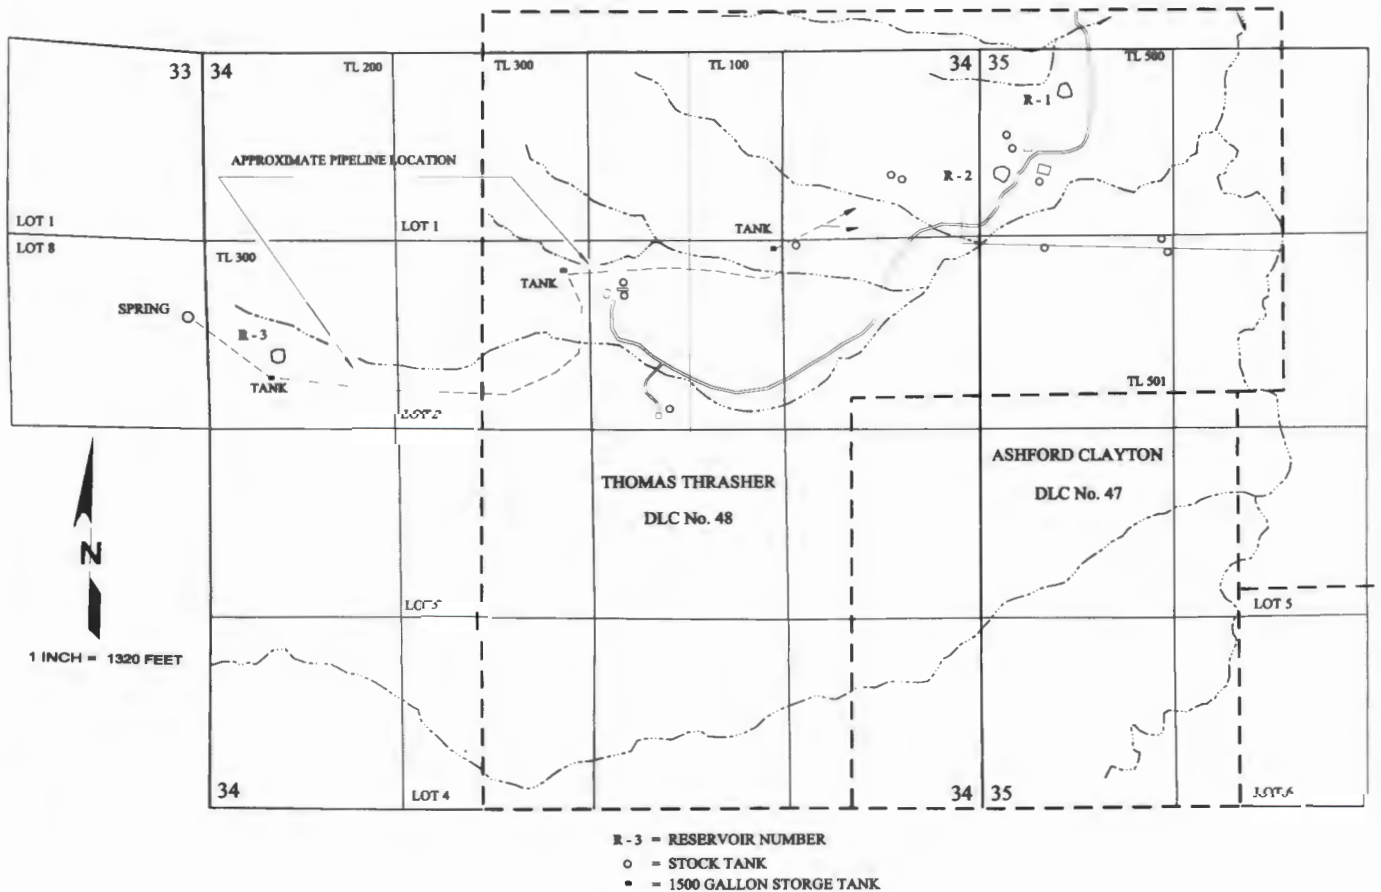


THE SPRING IS LOCATED 1840 FEET SOUTH AND 110 FEET WEST FROM THE NORTHWEST CORNER OF SECTION 34, BEING WITHIN THE SE $\frac{1}{4}$ NE $\frac{1}{4}$ OF SECTION 33; AND
RESERVOIR No. 1 IS LOCATED 280 FEET SOUTH AND 610 FEET EAST FROM THE NORTHWEST CORNER OF SECTION 35, BEING WITHIN NW $\frac{1}{4}$ NW $\frac{1}{4}$ OF SECTION 35; AND
RESERVOIR No. 2 IS LOCATED 880 FEET SOUTH AND 150 FEET EAST FROM THE NORTHWEST CORNER OF SECTION 35, BEING WITHIN THE NW $\frac{1}{4}$ NW $\frac{1}{4}$ OF SECTION 35; AND
RESERVOIR No. 3 IS LOCATED 2110 FEET SOUTH AND 550 FEET EAST FROM THE NORTHWEST CORNER OF SECTION 34, BEING WITHIN THE SW $\frac{1}{4}$ NW $\frac{1}{4}$ OF SECTION 34; ALL IN TOWNSHIP 25 SOUTH, RANGE 7 WEST, W.M.; DOUGLAS COUNTY.

RECEIVED

SEP 19 2000

WATER RESOURCES DEPT.
SALEM, OREGON

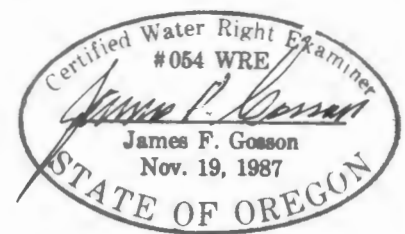

THE PURPOSE OF THIS MAP IS TO IDENTIFY THE LOCATION OF THE WATER RIGHT
IT IS NOT INTENDED TO PROVIDE INFORMATION RELATIVE TO THE LOCATION OF
PROPERTY OWNERSHIP BOUNDARY LINES.