



CLAIM OF BENEFICIAL USE MAP
FOR APPLICATION G-16775, PERMIT G-16276
IN THE NAME OF BOYD GATFIELD
SEC 2, T4N, R35E, W.M., UMATILLA COUNTY

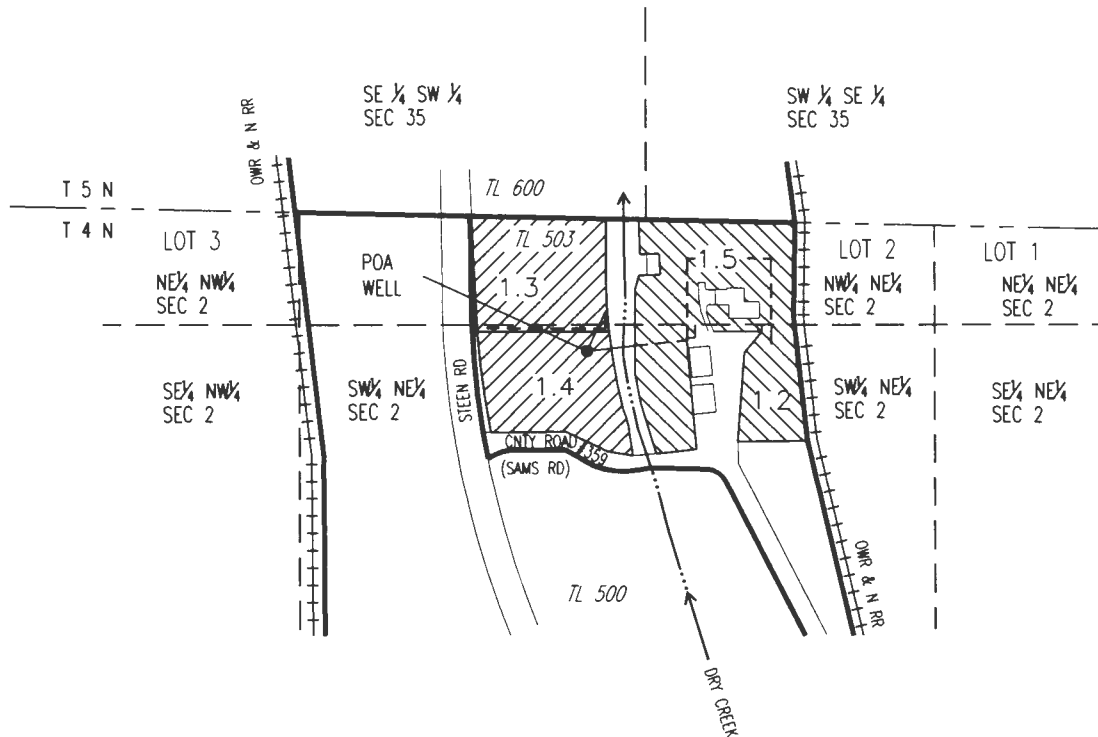


LEGEND



- POA - WELL, 3 hp SUBMERSIBLE PUMP LOCATED 270' S & 120' W OF THE SW CORNER OF THE SW 1/4 SE 1/4 OF SECTION 35, T5N, R35E W.M.

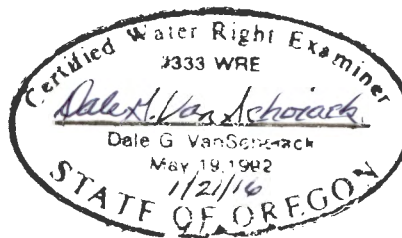

Renews
6/30/16

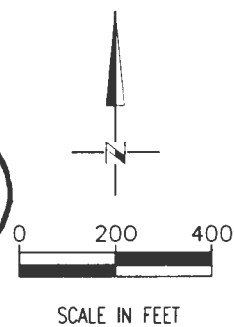

RECEIVED BY

28

DALE G

NOTE:
THE PURPOSE OF THIS MAP IS TO IDENTIFY THE APPROXIMATE LOCATION OF THE WATER RIGHT. IT IS NOT INTENDED TO PROVIDE INFORMATION RELATIVE TO THE LOCATION OF PROPERTY OWNERSHIP BOUNDARY LINES. PIPELINE SIZES AND LOCATIONS WERE PROVIDED BY FARM PERSONNEL AND HAVE NOT BEEN VERIFIED.

DGV Consulting, PLLC
PHONE (509) 627-8717
dalevconsulting@gmail.com
Date: Jan 18, 2016