


T. 4 S. , R. 2 W. , W.M.  
DONALD & CLARA BUYSERIE  
5674 BUYSERIE ROAD NE  
ST. PAUL, OR, 97137



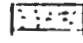
RECEIVED

FEB 14 2000


WATER RESOURCES DEPT.  
SALEM, OREGON

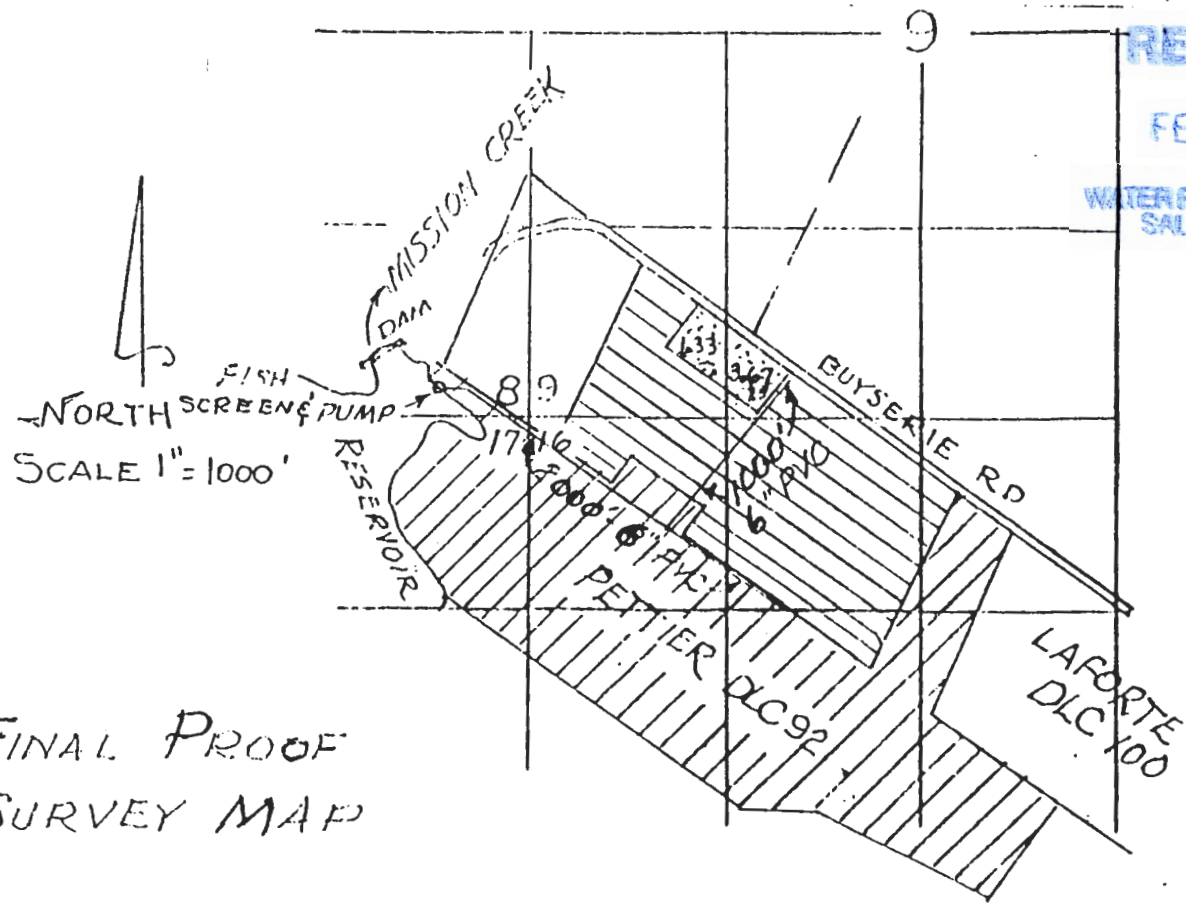

FINAL PROOF  
SURVEY MAP

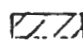-  PRIMARY
-  SUPPLEMENTAL TO GRIBIO
-  PROPOSED SUPPLEMENTAL

REFERENCE: FILE 8-80299

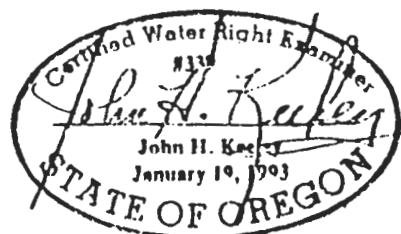

EXPIRATION DATE 06/30/01