


Claim of Beneficial Use
T-12401


9/29/2021

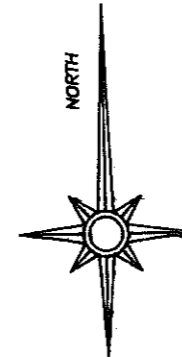

Renewal date: 6/30/2022



Legend

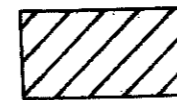

8.0 acres beneficially used as T-12401
(priority date 3/4/1980)

——— Property line

----- Mainline

RECEIVED

NOV 01 2021

OWRD

Point of Appropriation

355 feet north and 276 feet west from the Center 1/4
Corner of Section 5.



GRAPHIC SCALE - FEET

This map is for the purpose of identifying the location of the water right. It is not intended to provide legal dimensions or locations of property ownership lines.

TL 100

Tax Lots 100 and 101
Map 15-11-05

TL 101

Well
Meter

2.8

4.0

0.7

0.5

SE NW

SW NE

NW SE

NE SW

Center 1/4 Corner
Section 5

Section 5
T15S R11E, W.M.
Deschutes County, OR

Michele W. Sims Consultant, LLC

14865 Checkrein

Sisters, Oregon

97759

541-408-4777