ATTACH A-1/1

MAP FOR

Claim of Beneficial Use

Sections 9, 10, 15, 16, T4S, R2W, Marion County
T-13031

RECEIVED
FEB 22 2021
OWRD

N

1 IN = 1320 FT
0 660 1320

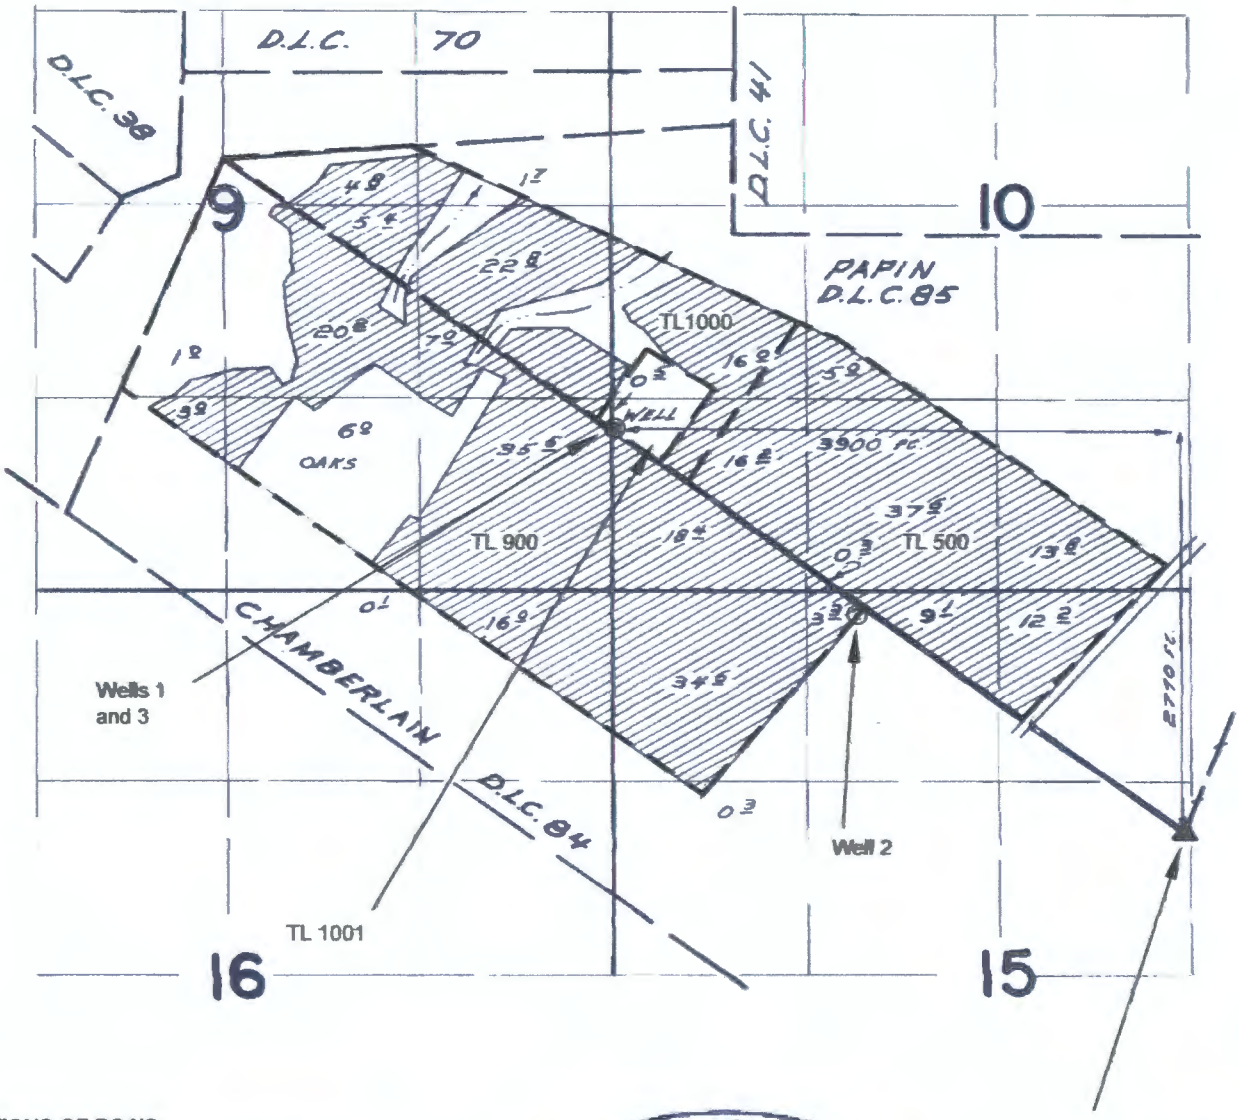

LOCATIONS OF POA'S:
Well #1 (MARI-1138) is 2770' N & 3900' W,
Well #2 (MARI-54631) is 1486' N & 2185' W,
Well #3 (MARI-69176) is 2790' N & 3915' W,
all from southerly SE DLC 85.

Certified Water Right Examiner
#385
Eric A. Urstadt
May 11, 1994
STATE OF OREGON

Southerly SE corner
DLC 85 (per map for
certificate 35498).

NOTES:
THIS MAP IS NOT INTENDED TO PROVIDE LEGAL DIMENSIONS OR LOCATIONS OF PROPERTY OWNERSHIP LINES.
-THIS MAP IS BASED ON THE FINAL PROOF SURVEY FOR CERTIFICATE 35948. AN AUG 2020 AERIAL PHOTO WAS USED TO LOCATE AND MAP THE WELLS. THE LOCATION OF THE SOUTHERLY SE OF DLC 85 IS PER SAID FINAL PROOF MAP AND WAS NOT CONFIRMED.
-WATER CONVEYANCE LINES SHALL BE ALL WITHIN THE PROPERTY AND THEREFORE ARE NOT SHOWN.

MAP BY:
ASPEN RURAL LAND CONSULTING
ERIC URSTADT, PE, PLS
971-250-1520
Jan 2021
BISky-StPaulW2A