


LEGEND

- TOWNSHIP LINE
- SECTION LINE
- 1/4 1/4 LINE
- TAX LOT LINE
- ROAD
- SECTION CORNER
- TAX LOT NUMBER
- GOVERNMENT LOT NUMBER
- WELL
- PLACE OF USE IRRIGATED FOR TRANSFER T-13039
- IRRIGATED ACRES
- 1/4 1/4 SECTION

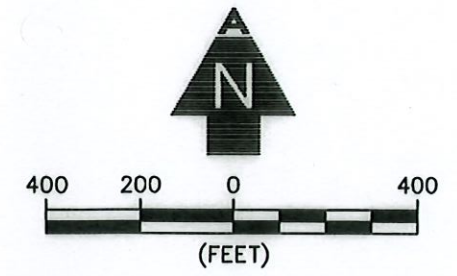

RECEIVED
 JAN 06 2021
 OWRD

WELL LOCATIONS

POA 1 (Klam 51232): T36S, R10E, SEC. 3, NW1/4 NE1/4; 990 FEET SOUTH & 1980 FEET WEST FROM NE CORNER, SECTION 3.

POA 2 (Klam 59194): T35S, R10E, SEC. 34, NW1/4 SE1/4; 1830 FEET WEST & 1620 FEET NORTH FROM NE CORNER, SECTION 3. LATITUDE: 42.49096000; LONGITUDE: -121.51324000.

NOTES

1. THE PURPOSE OF THIS MAP IS TO IDENTIFY THE LOCATION OF THE WATER RIGHT ONLY, AND IS NOT INTENDED TO PROVIDE DIMENSIONS OR LOCATION OF PROPERTY LINES.
2. PRIORITY DATE FOR THIS WATER RIGHT IS NOVEMBER 24, 2003.

CERTIFIED WATER RIGHT EXAMINER
 #88332CWRE

 Daniel B. Scalas
 April 23, 2015
 STATE OF OREGON
 RENEWAL 06/30/22

AL ADKINS ENGINEERING & SURVEYING
 1435 ESPLANADE AVENUE, KLAMATH FALLS, OR 97601
 o / 541.884.4666
 w / AdkinsEngineering.com

SERVING S. OREGON & N. CALIFORNIA
 ENGINEERING • SURVEYING • PLANNING • TESTING

CLAIM OF BENEFICIAL USE MAP
 FOR
 BENTON ETHAN DEMAREE & MORGAN PARKER DEMAREE
 T35S, R10E, SEC. 34, & T36S, R10E, SEC. 3, WM
 KLAMATH COUNTY, OREGON
 TRANSFER T-13039